



DEPARTMENT OF REGULATORY AND ECONOMIC RESOURCES (RER)
BOARD AND CODE ADMINISTRATION DIVISION

NOTICE OF ACCEPTANCE (NOA)

MIAMI-DADE COUNTY, FLORIDA
PRODUCT CONTROL SECTION
11805 SW 26 Street, Room 208
T (786) 315-2590 F (786) 315-2599

www.miamidade.gov/economy

Kawneer Company, Inc.

555 Guthridge Court

Norcross, GA 30092

SCOPE:

This NOA is being issued under the applicable rules and regulations governing the use of construction materials. The documentation submitted has been reviewed and accepted by Miami-Dade County RER-Product Control Section to be used in Miami-Dade County and other areas where allowed by the Authority Having Jurisdiction (AHJ).

This NOA shall not be valid after the expiration date stated below. The Miami-Dade County Product Control Section (in Miami-Dade County) and/ or the AHJ (in areas other than Miami-Dade County) reserve the right to have this product or material tested for quality assurance purposes. If this product or material fails to perform in the accepted manner, the manufacturer will incur the expense of such testing and the AHJ may immediately revoke, modify, or suspend the use of such product or material within their jurisdiction. RER reserves the right to revoke this acceptance, if it is determined by Miami-Dade County Product Control Section that this product or material fails to meet the requirements of the applicable building code.

This product is approved as described herein, and has been designed to comply with the Florida Building Code, including the High Velocity Hurricane Zone.

DESCRIPTION: Series "1630-SS-IR Dry Glazed" 8-¹³/₁₆" Aluminum Curtain Wall System – S.M.I.

APPROVAL DOCUMENT: Drawing No. 1848, Series titled "8¹³/₁₆" Deep 1630-SS-IR Dry Glazed SMI Curtain Wall", sheets 01 through 21 of 21, dated 01/15/13, prepared by W. W. Schaefer Engineering & Consulting, P. A., signed and sealed by Warren W. Schaefer, P. E., bearing the Miami-Dade County Product Control Section Revision stamp with the Notice of Acceptance number and Expiration date by the Miami-Dade County Product Control Section.

MISSILE IMPACT RATING: Small Missile Impact Resistant

LABELING: Each unit shall bear a permanent label with the manufacturer's name or logo, city, state, series, and following statement: "Miami-Dade County Product Control Approved", unless otherwise noted herein.

RENEWAL of this NOA shall be considered after a renewal application has been filed and there has been no change in the applicable building code negatively affecting the performance of this product.

TERMINATION of this NOA will occur after the expiration date or if there has been a revision or change in the materials, use, and/ or manufacture of the product or process. Misuse of this NOA as an endorsement of any product, for sales, advertising or any other purposes shall automatically terminate this NOA. Failure to comply with any section of this NOA shall be cause for termination and removal of NOA.

ADVERTISEMENT: The NOA number preceded by the words Miami-Dade County, Florida, and followed by the expiration date may be displayed in advertising literature. If any portion of the NOA is displayed, then it shall be done in its entirety.

INSPECTION: A copy of this entire NOA shall be provided to the user by the manufacturer or its distributors and shall be available for inspection at the job site at the request of the Building Official.

This NOA revises NOA No. 13-0522.13 and consists of this page 1 and evidence pages E-1 and E-2, as well as approval document mentioned above.

The submitted documentation was reviewed by **Jaime D. Gascon, P. E.**



J. Gascon
9/10/14

NOA No. 14-0430.34

Expiration Date: August 08, 2018

Approval Date: September 18, 2014

Page 1

NOTICE OF ACCEPTANCE: EVIDENCE SUBMITTED

A. DRAWINGS

1. Manufacturer's die drawings and sections.
(Submitted under previous NOA No. 13-0522.13)
2. Drawing No. 1848, Series titled "8¹³/₁₆" Deep 1630-SS-IR Dry Glazed SMI Curtain Wall", sheets 01 through 21 of 21, dated 01/15/13, prepared by W. W. Schaefer Engineering & Consulting, P. A., signed and sealed by Warren W. Schaefer, P. E.
(Submitted under previous NOA No. 13-0522.13)

B. TESTS

1. Test reports on:
 - 1) Air Infiltration Test, per FBC, TAS 202-94
 - 2) Uniform Static Air Pressure Test, Loading per FBC, TAS 202-94
 - 3) Water Resistance Test, per FBC, TAS 202-94
 - 4) Dynamic Water Penetration Test, per AAMA 501.1
 - 5) Small Missile Impact Test per FBC, TAS 201-94 and ASTM E 1886-05/ E1996-09
 - 6) Large Missile Impact Test per FBC, TAS 201-94 and ASTM E 1886-05/ E1996-09
 - 7) Thermal Cycling Test per AAMA 501.5
 - 8) Cyclic Wind Pressure Loading per FBC, TAS 203-94 and ASTM E 1886-05/ E1996-09

along with marked-up drawings and installation diagram of an Aluminum curtain wall system, prepared by Architectural Testing, Inc., Test Reports No.'s ATI-C0438.01-450-18 and ATI-C0438.02-450-18, both dated 03/28/13, signed and sealed by Vinu J. Abraham, P. E.

(Submitted under previous NOA No. 13-0522.13)

C. CALCULATIONS

1. Anchor verification calculations and structural analysis, complying with FBC, dated 01/15/13, prepared by W. W. Schaefer Engineering & Consulting, P. A., signed and sealed by Warren W. Schaefer, P. E.
(Submitted under previous NOA No. 13-0522.13)
2. Glazing complies with ASTM E1300-04/ 09

D. QUALITY ASSURANCE

1. Miami-Dade Department of Regulatory and Economic Resources (RER).

E. MATERIAL CERTIFICATIONS

1. Notice of Acceptance No. 13-0129.27, issued to E.I. DuPont DeNemours & Co., Inc. for their "DuPont Butacite® PVB Interlayer" dated 04/11/13, expiring on 12/11/16.



Jaime D. Gascon, P. E.
Product Control Section Supervisor
NOA No. 14-0430.34
Expiration Date: August 08, 2018
Approval Date: September 18, 2014

NOTICE OF ACCEPTANCE: EVIDENCE SUBMITTED

E. MATERIAL CERTIFICATIONS (CONTINUED)


2. Notice of Acceptance No. **14-0423.15** issued to **Eastman Chemical Company (MA)** for their "**Saflex CP – Saflex and Saflex HP Composite Glass Interlayers with PET Core**" dated 06/19/14, expiring on 12/11/18.
3. Test Report No. **73703**, prepared by Excel Polymers, LLC, an A2LA accredited laboratory, dated 04/11/11, issued to Tremco, Inc. for TREMCO Part No. **TR-20494P** EPDM exterior glazing gasket complying with ASTM D573 70 HRS at 212°F, D412 1800 PSI, D395B 22 HRS at 158°F, D1149 100 HRS at 104°F passed, D325B passed and D2137 3–Minutes at –40°F passed.
(Submitted under previous NOA No. 13-0522.13)
4. Test Report No. **74326**, prepared by Excel Polymers, LLC, an A2LA accredited laboratory, dated 04/26/11, issued to Tremco, Inc. for TREMCO Part No. **TR-20087E** EPDM exterior glazing gasket complying with ASTM D573 70 HRS at 212°F, ASTM D412 1800 PSI, D395B 22 HRS at 158°F, D1149 100 HRS at 104°F passed, D325B passed and D2137 method A 3–Minutes at –40°F passed, D2240 durometer 70^{±5} shore A, D624 tear die 200lbf/in. and D925 migration stain passed.
(Submitted under previous NOA No. 13-0522.13)

D. STATEMENTS

1. Statement letter of conformance and complying with **FBC 5th Edition (2014)**, dated 04/14/14, issued by W. W. Schaefer Engineering & Consulting, P. A., signed and sealed by Warren W. Schaefer, P. E.
2. Statement letter of conformance and complying with **FBC-2010**, dated 01/09/13, issued by W. W. Schaefer Engineering & Consulting, P. A., signed and sealed by Warren W. Schaefer, P. E. *(Submitted under previous NOA No. 13-0522.13)*
3. Statement letter of no financial interest and independence, dated 01/09/13, issued by W. W. Schaefer Engineering & Consulting, P. A., signed and sealed by Warren W. Schaefer, P. E. *(Submitted under previous NOA No. 13-0522.13)*
4. Laboratory compliance letters for Test Reports No.'s **ATI-C0438.01-450-18** and **ATI-C0438.02-450-18**, issued by Architectural Testing, Inc., both dated 03/28/13, signed and sealed by Vinu J. Abraham, P. E.
(Submitted under previous NOA No. 13-0522.13)
5. Proposal No. **11-0217** issued by Product Control, dated 06/15/12, signed by Jaime D. Gascon, P. E. *(Submitted under previous NOA No. 13-0522.13)*

G. OTHERS

1. Notice of Acceptance No. **13-0522.13**, issued to Kawneer Company, Inc. for their Series "**1630-SS-IR Dry Glazed 8-¹³/₁₆" Aluminum Curtain Wall System – S.M.I.**", approved on 08/08/13 and expiring on 08/08/18.


Jaime D. Gascon, P. E.
Product Control Section Supervisor
NOA No. 14-0430.34
Expiration Date: August 08, 2018
Approval Date: September 18, 2014

1. THESE CURTAIN WALL SYSTEMS HAVE BEEN TESTED, ANALYZED & APPROVED FOR DESIGN PRESSURES NOT TO EXCEED THOSE SHOWN IN THE "ALLOWABLE DESIGN PRESSURE TABLE(S)".
2. OPENINGS, BUCKING & BUCKING FASTENERS MUST BE PROPERLY DESIGNED & INSTALLED TO TRANSFER WIND LOADS TO THE STRUCTURE.
3. ALL HARDWARE & FASTENERS SHALL BE IN ACCORDANCE WITH THESE DRAWINGS & SHALL NOT VARY UNLESS SPECIFICALLY MENTIONED ON THE DRAWINGS. SPECIFIED ANCHOR EMBED TO BASE MATERIAL SHALL BE BEYOND WALL FINISH OR STUCCO.
4. THE DETAILS & SPECIFICATIONS SHOWN HEREIN REPRESENT THE PRODUCTS TESTED & PROPOSED FOR WATER, AIR, IMPACT, CYCLIC & UNIFORM STATIC AIR PRESSURE TESTING IN CONFORMANCE WITH THE FLORIDA BUILDING CODE PROTOCOLS TAS-201, 202 & 203 FOR SMALL MISSILE IMPACT CURTAIN WALL SYSTEMS.
5. THESE CURTAIN WALL SYSTEMS HAVE BEEN DESIGNED IN ACCORDANCE WITH AND MEET THE REQUIREMENTS OF THE FLORIDA BUILDING CODE (FBC) INCLUDING HIGH VELOCITY HURRICANE ZONES (HVHZ).
6. THIS CURTAIN WALL SYSTEM MAY NOT BE INSTALLED AT ELEVATIONS BELOW 30 FT. ABOVE GRADE WITHOUT AN APPROVED SHUTTER.
7. ALL ANCHORS SECURING CURTAIN WALL FRAME TO PRESSURE TREATED BUCKS OR WOOD FRAMING SHALL BE CAPABLE OF RESISTING CORROSION CAUSED BY THE PRESSURE TREATING CHEMICALS IN THE WOOD.
8. DETERMINE THE POSITIVE & NEGATIVE DESIGN LOADS TO USE WHEN REFERENCING THESE DOCUMENTS IN ACCORDANCE WITH THE GOVERNING CODE AND GOVERNING WIND VELOCITY. FOR WIND LOAD CALCULATIONS IN ACCORDANCE WITH THE FLORIDA BUILDING CODE, A DIRECTIONALITY FACTOR OF $KD = 0.85$ MAY BE APPLIED WHEN USED IN CONJUNCTION WITH LOAD COMBINATIONS SPECIFIED IN SECTION 2.0 OF THE ASCE 7 STANDARD.
9. NO INCREASE IN ALLOWABLE STRESS HAS BEEN USED IN THE CERTIFICATION OF THIS PRODUCT. WIND LOAD DURATION FACTOR $CD = 1.6$ WAS USED. FOR WOOD SCREW ANALYSIS ONLY.
10. MATERIALS, INCLUDING BUT NOT LIMITED TO STEEL SCREWS, THAT COME INTO CONTACT WITH OTHER DISSIMILAR MATERIALS SHALL MEET THE REQUIREMENTS OF FLORIDA BUILDING CODE CHAPTER 20.
11. THERE SHALL BE NO LIMIT TO THE NUMBER OF HORIZONTAL & VERTICAL PANELS USED FOR ANY JOB PROVIDING ALL RESTRICTIONS ARE MET PER THE ELEVATIONS.

1. DETERMINE IF THE WALL SYSTEM IS TO BE A MULTI-SPAN OR SINGLE SPAN CONDITION. IF MULTI-SPAN, THE ELEVATIONS SHOWN ON SHEET 3 SHALL APPLY. IF A SINGLE SPAN, THE ELEVATIONS SHOWN ON SHEET 4 SHALL APPLY.

| OPENING TYPE (SUBSTRATE) | ANCHOR TO OPENING FASTENER TYPE | MINIMUM EMBED | MINIMUM EDGE DIST. |
|--|---|------------------|-----------------------|
| 1/4" OR NO. 14 SCREWS/BOLTS | | | |
| (4) MIN. 6" WIDE X 2" THICK WOOD FRAME OR BUCK (MIN. GR. 2 & G=0.55) | 1/4" LAG OR NO. 14 SMS OR WOOD SCREW | 1 3/4" | 1" |
| (4) MIN. 16 GA. 50 KSI METAL STUD, MIN. 1/8" THK A36 STEEL OR MIN. 1/8" THK 6063-T5 ALUMINUM | 1/4-14 GR. 5 SELF TAP/DRILL SCREW | FULL | 1/2" |
| | 1/4" GR. 5 CS OR 410 SS BOLT WITH WASHER & LOCK NUT | FULL | 1/2" |
| MIN. 3000 PSI CONCRETE | (1) 1/4" CONCRETE SCREW | 1 3/4" | 2" |
| 5/16" SCREWS/BOLTS | | | |
| MIN. 1/8" THK A36 STEEL | 5/16-24 GR. 5 SELF TAP/DRILL SCREW | FULL | 5/8" |
| | 5/16" GR. 5 CS OR 410 SS BOLT WITH WASHER & LOCK NUT | FULL | 5/8" |
| 1/2" SCREWS/BOLTS | | | |
| MIN. 1/4" THK A36 STEEL | 1/2-13 300 SS HCMS OR GR. 5 CS THREAD FORMING SCREW | FULL | 1" |
| MIN. 1/8" THK A36 STEEL | 1/2" GR. 5 CS OR 410 SS BOLT WITH WASHER & LOCK NUT | FULL | 1" |
| (3) MIN. 3000 PSI CONCRETE | (2) 1/2" CONCRETE SCREW ANCHOR | 3 3/4" | SEE DETAILS |

- (1) CONCRETE SCREWS SHALL BE ELCO ULTRACONS (C.S.), ELCO CRETE-FLEX (S.S.), ITW RAMSET/RED HEAD TAPCONS (C.S. OR S.S.) OR HILTI KWIK-CON II (C.S OR S.S.).
- (2) 1/2" CONCRETE SCREWS SHALL BE SIMPSON STRONG-TIE TITAN HD SCREW ANCHOR (GALVANIZED STEEL).
- (3) SEE DETAILS ON SHEETS 8 & 9 FOR CONCRETE THICKNESS REQUIREMENTS WHEN 1/2" CONCRETE SCREWS ARE USED.
- (4) WOOD AND METAL STUD SUBSTRATES MAY NOT APPLY WITH LEVEL "E" CURTAIN WALL.

HEAD & SILL MEMBERS TO STANDARD VERTICAL SIDE & INTERMEDIATE MEMBERS: VERTICAL MEMBERS RUN THROUGH WHILE THE HORIZONTAL MEMBERS ARE SQUARE CUT, BUTTED AND MECHANICALLY FASTENED THROUGH VERTICAL MEMBERS & INTO THE HORIZONTAL MEMBERS SCREW SPLINES WITH 2 NO. 12 X 1" HWHTTF SCREWS. CORNERS ARE SEALED WITH DOW 795 SILICONE SEALANT.

INTERMEDIATE HORIZONTAL MEMBERS TO STANDARD VERTICAL SIDE & INTERMEDIATE MEMBERS: VERTICAL MEMBERS RUN THROUGH WHILE THE HORIZONTAL MEMBERS ARE SQUARE CUT, BUTTED AND MECHANICALLY FASTENED THROUGH VERTICAL MEMBERS & INTO THE HORIZONTAL MEMBERS SCREW SPLINES WITH 4 NO. 12 X 1" HWHTTF SCREWS. CORNERS ARE SEALED WITH DOW 795 SILICONE SEALANT.

HEAD & SILL MEMBERS TO CORNER FRAMING MEMBER: VERTICAL CORNER MEMBERS RUN THROUGH WHILE THE HORIZONTAL MEMBERS ARE MITER CUT, BUTTED AND MECHANICALLY FASTENED TO THE VERTICAL MEMBERS VIA A SHEAR BLOCK (ITEMS #9 OR #10). THE SHEAR BLOCK IS MECHANICALLY FASTENED TO THE VERTICAL CORNER FRAME MEMBERS WITH 4 NO. 12 X 7/16" PHTF SCREWS. THE HORIZONTAL FRAME MEMBERS ARE ATTACHED TO THE SHEAR BLOCK WITH 2 NO. 12 X 5/8" PHTF SCREWS. CORNERS ARE SEALED WITH DOW 795 SILICONE SEALANT.

INTERMEDIATE HORIZONTAL MEMBERS TO CORNER FRAMING MEMBER: VERTICAL MEMBERS RUN THROUGH WHILE THE HORIZONTAL MEMBERS ARE SQUARE CUT, BUTTED AND MECHANICALLY FASTENED TO THE VERTICAL MEMBERS VIA A SHEAR BLOCK (ITEM #11). THE SHEAR BLOCK IS MECHANICALLY FASTENED TO THE VERTICAL CORNER FRAME MEMBERS WITH 4 NO. 12 X 7/16" PHTF SCREWS. THE HORIZONTAL FRAME MEMBERS ARE ATTACHED TO THE SHEAR BLOCK WITH 4 NO. 12 X 1" FHIF SCREWS. CORNERS ARE SEALED WITH DOW 795 SILICONE SEALANT.

THE MINIMUM & MAXIMUM ALLOWABLE SPACE BETWEEN PERIMETER FRAME MEMBERS & THE OPENING SUBSTRATE OR FINISHES SHALL BE SPECIFIED BY THE ENGINEER OR ARCHITECT OF RECORD FOR EACH JOB BUT SHALL NOT BE LESS THAN 1/2" NOR GREATER THAN 1 3/8". WHEN CONSIDERING TYPE, DEPTH & JOINT SPAN OF SEALANT, THE ENGINEER/ARCHITECT SHALL TAKE INTO CONSIDERATION THE DEFLECTION OF THE JAMB MEMBER THAT WOULD OCCUR WHILE SUPPORTING THE JOB REQUIRED DESIGN WIND PRESSURE. ALSO TO BE CONSIDERED SHALL BE THE MATERIALS & SURFACES TO WHICH THE SEALANT WILL BE APPLIED.

1. $L/180$ = MEMBER'S UNSUPPORTED SPAN LENGTH DIVIDED BY 180.
2. THIS IS THE MAXIMUM ALLOWABLE DEFLECTION AS RESTRICTED BY TESTING & THE BUILDING CODE. IF JOB CONDITIONS REQUIRE LESS DEFLECTION, THE JOB CONDITIONS SHALL CONTROL.

1. THE ABOVE STATED PRESSURES ARE THE MAXIMUM ALLOWED ON ANY JOB REGARDLESS OF WHAT THE JOB SPECIFIC DESIGN RESULTS MAY SHOW. INCREASE OF ALLOWABLE DESIGN PRESSURE ON ANY JOB IS CONSIDERED OUTSIDE THE SCOPE OF THIS APPROVAL. SEE "CURTAIN WALL DESIGN NOTES" ON THIS SHEET FOR ACTUAL JOB DESIGN CONDITIONS.

| GLASS OPTIONS | MAXIMUM D.L.O. WIDTH | MAXIMUM D.L.O. HEIGHT | MISSILE LEVEL RATING | ALLOWABLE DESIGN PRESSURE |
|---------------------------------------|----------------------------|-----------------------------|----------------------------|---------------------------------|
| 1 & 2 | 60" | 93" | S.M.I. | +/-130 PSF |
| | 93" | 60" | S.M.I. | +/-130 PSF |
| SEE GLAZING DETAILS FOR GLASS OPTIONS | | | | |

Approved as complying with the
Florida Building Code
Date 08/08/201
NOA# 13-0522
Miami Trade Product Control

THESE DRAWINGS ARE APPLICABLE ONLY TO THE PRODUCT SPECIFIED. THEY MAY NOT BE USED FOR THE ASSEMBLY AND/OR INSTALLATION OF ANY OTHER PRODUCT NOR MAY THEY BE USED FOR NATIONAL AND/OR LOCAL APPROVAL OF ANY PRODUCT NOT PRODUCED BY THE MANUFACTURER STATED ON THESE DRAWINGS.

[illegible]

| VERTICAL MEMBER END ANCHOR REACTION LOAD CAPACITY (MULTI & SINGLE SPAN CURTAIN WALL) | | |
|---|--|-------------------------------------|
| ANCHOR SECTION (3) | ANCHOR DESCRIPTION | (1) MAXIMUM ALLOWABLE REACTION LOAD |
| A1 | SIDE MEMBER TO WOOD, METAL STUD OR ALUMINUM SUBSTRATE | 877 LBS |
| A2 | SIDE MEMBER TO STEEL SUBSTRATE | 2058 LBS |
| A3 | SIDE MEMBER TO CONCRETE SUBSTRATE | 1990 LBS |
| B1 | INTERMEDIATE MEMBER TO WOOD, METAL STUD OR ALUMINUM SUBSTRATE | 1646 LBS |
| B2 | INTERMEDIATE MEMBER TO STEEL SUBSTRATE | 4515 LBS |
| B3 | INTERMEDIATE MEMBER TO CONCRETE SUBSTRATE | 3626 LBS |
| C1 | INTERMEDIATE DOOR JAMB MEMBER TO CONCRETE OR STEEL SUBSTRATE AT SILL | 3511 LBS |
| D1 | CORNER MEMBER TO STEEL SUBSTRATE | (2) 2726 LBS |
| D2 | CORNER MEMBER TO CONCRETE SUBSTRATE | (2) 2726 LBS |

- (1) MAXIMUM ALLOWABLE REACTION LOADS SHOWN CONSIDER REACTIONS FROM WIND LOADS ONLY & APPLY TO BOTH POSITIVE & NEGATIVE WIND DIRECTIONS. IN ADDITION TO WIND LOADS, THE CURTAIN WALL DESIGN ENGINEER OF RECORD FOR EACH PROJECT SHALL ALSO CONSIDER OTHER APPLICABLE LOADS SUCH AS, BUT POSSIBLY NOT LIMITED TO, DEAD LOADS FROM THE CURTAIN WALL WEIGHT.
- (2) REACTION LOAD SHOWN FOR THE CORNER ANCHORS IS THE RESULTANT LOAD IN THE PLANE OF THE MULLION (LOAD FROM BOTH SIDES COMBINED INTO A RESULTANT). FOR EITHER SIDE LOAD, THE ALLOWABLE REACTION LOAD SHALL NOT EXCEED 1928 LBS FROM EITHER SIDE FOR ANCHOR TYPES D1 & D2.
- (3) FOR ANCHOR SECTIONS, SEE SECTIONS ON SHEETS 7 & 8.

CURTAIN WALL DESIGN NOTES:

- WITH EACH APPLICABLE JOB, SHOP DRAWINGS SHALL BE PREPARED AND CERTIFIED BY A LICENSED ENGINEER EXPERIENCED WITH CURTAIN WALL DESIGN.
- THE RESPONSIBLE ENGINEER SHALL DESIGN THE WALL SYSTEM SEPARATELY FOR EACH JOB & CONFIRM THAT ALL CONDITIONS STATED HERE-IN HAVE BEEN CONSIDERED AND ADHERED TO IN THAT DESIGN.
- IN HIS/HER DESIGN, THE RESPONSIBLE ENGINEER SHALL VERIFY THE INTEGRITY OF ALL CONNECTIONS AND FRAMING MEMBERS & SHALL TAKE FULL RESPONSIBILITY FOR THE INTEGRITY OF THE SYSTEM DESIGN AS A WHOLE WHILE NOT ALLOWING THE CONDITIONS STATED HERE-IN TO BE EXCEEDED. ALLOWABLE SUPPORT REACTIONS AND VERTICAL FRAMING MEMBER BENDING MOMENTS SHALL NOT EXCEED THOSE STATED IN THE TABLES ON THIS SHEET, REGARDLESS OF JOB DESIGN.
- THE CURTAIN WALL DESIGN ENGINEER SHALL CONSIDER ALL APPLICABLE REACTION LOADS IN HIS/HER DESIGN WHILE NOT ALLOWING THE REACTIONS RESULTING FROM WIND LOADS TO EXCEED THOSE SPECIFIED IN THE ANCHOR REACTION LOAD TABLE.
- THE WORSE CASE OF THE CONDITIONS SPECIFIED IN THIS PRODUCT APPROVAL DRAWING AND THOSE DETERMINED BY THE INDIVIDUAL JOB ENGINEER'S ANALYSIS & DESIGN SHALL CONTROL AS APPLICABLE FOR THE ACTUAL JOB.
- REGARDLESS OF JOB DETERMINED MEMBER STRESS & DEFLECTION CONDITIONS, THE FOLLOWING SHALL APPLY:
 - REINFORCEMENT TYPE R1 MUST BE PLACED BETWEEN SUPPORTS IN ALL VERTICAL FRAME MEMBERS THAT SPAN OVER 132" BETWEEN THEIR SUPPORTS (NOT REQUIRED IF THE UNSUPPORTED SPAN IS 132" OR LESS & THE JOB DESIGN ALLOWS FOR NO REINFORCEMENT).
 - REINFORCEMENT TYPE R2 MUST BE PLACED BETWEEN SUPPORTS IN ALL VERTICAL FRAME MEMBERS THAT SPAN OVER 144" BETWEEN THEIR SUPPORTS (NOT REQUIRED IF THE UNSUPPORTED SPAN IS 144" OR LESS & THE JOB DESIGN ALLOWS FOR LESSER OR NO REINFORCEMENT).
 - ALL VERTICAL INTERMEDIATE FRAMING MEMBERS SHALL BE REINFORCED ACROSS ALL INTERMEDIATE WIND LOAD ANCHOR LOCATIONS WITH ONE OF THE REINFORCEMENT TYPES R1 OR R2 AS SPECIFIED IN THE ELEVATION. THIS REINFORCEMENT SHALL EXTEND A MINIMUM OF 18" ABOVE & BELOW THE SUPPORT.
 - REINFORCEMENT TYPE R3 IS REQUIRED IN ALL VERTICAL CORNER FRAME MEMBERS. IT SHALL BE CONTINUOUS BETWEEN ALL MEMBER SPLICE JOINTS AND EXTEND TO WITHIN 15" OF WALL BASE, 15" OF A SPLICE & 15" OF THE WALL TOP.
- REINFORCEMENT IS NOT REQUIRED TO BE CONTINUOUS TOP TO BOTTOM WITHIN THE VERTICAL FRAMING MEMBERS. REINFORCEMENT MAY BE NON-CONTINUOUS, AS DETERMINED FOR EACH JOB, PROVIDING IT MEETS THE MINIMUM GUIDELINES OF THIS DRAWING.
- WHILE A TWIN SPAN IS SHOWN, MORE THAN 2 SPANS MAY EXIST WITHIN THE MAXIMUM OVERALL HEIGHT SHOWN.
- THE OVERALL CURTAIN WALL HEIGHT SHALL NOT EXCEED THAT SPECIFIED. HOWEVER, MORE THAN ONE CURTAIN WALL ASSEMBLY MAY BE STACKED ON ANY BUILDING PROVIDING EACH CURTAIN WALL ASSEMBLY IS RESTED ON SEPARATE BASE STRUCTURE.
- SPLICING OF VERTICAL FRAME MEMBERS MAY OCCUR BETWEEN SUPPORTS AS REQUIRED. LOCATION OF THOSE SPLICES SHALL BE WHERE A BENDING MOMENT OF NEAR ZERO(0) EXISTS IN THE MEMBER.
- THE ELEVATIONS SHOW ONE DOOR SECTION. MULTIPLE DOOR SECTIONS MAY OCCUR SIDE-BY-SIDE IN ONE WALL SYSTEM PROVIDING ALL REQUIREMENTS WITHIN THIS DRAWING ARE MET AND THE JOB DESIGN ALLOWS FOR THE MULTIPLE DOOR CONDITION.
- ALTHOUGH A DOOR SECTION IS SHOWN, THAT SECTION MAY EXIST WITH OR WITHOUT A DOOR.
- DOORS MUST ALWAYS BE PLACED BETWEEN 2 INTERMEDIATE VERTICAL FRAMING MEMBERS. THEY MAY NOT BE PLACED AGAINST A SIDE MEMBER.
- THERE IS NO LIMIT TO THE NUMBER OF SECTIONS HORIZONTALLY PROVIDING THE OPENING IS DESIGNED TO SUPPORT THE LOADS TRANSFERRED FROM THE WALL SYSTEM.
- ANY CONDITIONS THAT VARY FROM THOSE SPECIFIED HERE-IN SHALL BE SUBJECT TO SEPARATE EVALUATION AND CERTIFICATION BY A FLORIDA P.E. AND SHALL BE CONSIDERED OUTSIDE THE SCOPE OF THIS APPROVAL.

| WIND LOAD ANCHOR REACTION LOAD CAPACITY (MULTI & SINGLE SPAN CURTAIN WALL) | |
|---|-------------------------------------|
| MEMBER TYPE | (1) MAXIMUM ALLOWABLE REACTION LOAD |
| SIDE | 6125 LBS |
| INTERMEDIATE | 11789 LBS |
| CORNER | (2) 8661 LBS |

(1) WIND LOAD ANCHORS ARE APPLICABLE FOR WIND LOAD RESISTANCE ONLY. THEY ARE NOT APPLICABLE FOR SUPPORT OF WALL WEIGHT.

(2) REACTION LOAD SHOWN FOR THE CORNER ANCHORS IS THE RESULTANT LOAD IN THE PLANE OF THE MULLION (LOAD FROM BOTH SIDES COMBINED INTO A RESULTANT). FOR EITHER SIDE LOAD, THE ALLOWABLE REACTION LOAD SHALL NOT EXCEED 6125 LBS FROM EITHER SIDE.

| (1) MAXIMUM ALLOWABLE BENDING MOMENTS IN VERTICAL FRAMING MEMBERS (MULTI AND SINGLE SPAN WALLS) | |
|--|--|
| (2) VERTICAL MEMBER | (3) MAXIMUM ALLOWABLE BENDING MOMENT (POS & NEG) |
| SIDE MEMBER WITH REINFORCEMENT "R0" | (5) 61558 IN-LB |
| SIDE MEMBER WITH REINFORCEMENT "R1" | (5) 104060 IN-LB |
| SIDE MEMBER WITH REINFORCEMENT "R2" | (5) 104060 IN-LB |
| INTERMEDIATE MEMBER WITH NO REINFORCEMENT | 56110 IN-LB |
| INTERMEDIATE MEMBER WITH REINFORCEMENT "R1" | 98309 IN-LB |
| INTERMEDIATE MEMBER WITH REINFORCEMENT "R2" | 185145 IN-LB |
| CORNER MEMBER WITH REINFORCEMENT "R3" | (4) 147141 IN-LB |

- NOTES:
- (1) THE VALUES IN THIS TABLE ARE APPLICABLE TO THE JOB REQUIRED DESIGN OF THE MULTI-SPAN & SINGLE SPAN WALL SYSTEMS.
- (2) FOR DESCRIPTIONS OF REINFORCEMENTS, SEE THE "VERTICAL MEMBER REINFORCEMENT LEGEND".
- (3) ALL VALUES ARE BASED ON THE LESSER OF TESTED MOMENT AND ALLOWABLE MOMENT.
- (4) MOMENT VALUE SHOWN FOR THE CORNER MULLION IS DUE TO THE RESULTANT LOAD IN THE PLANE OF THE MULLION (LOAD FROM BOTH SIDES COMBINED INTO A RESULTANT). FOR SINGLE SIDE LOAD, THE ALLOWABLE MOMENT SHALL NOT EXCEED 104060 IN-LB. IN THAT DIRECTION (LOAD VECTOR 45 DEGREES TO MULLION ANGLE).
- (5) WHEN 2 SIDE MEMBERS ARE USED TO FORM A CORNER, EACH SIDE MEMBER SHALL BE RESTRICTED TO THE INDIVIDUAL ALLOWABLE MOMENT SHOWN IN THIS TABLE (EACH CONSIDERED TO RESIST ITS OWN SINGLE SIDE LOAD).


VERTICAL MEMBER REINFORCEMENT LEGEND

- [R0] = NO REINFORCEMENT
- [R1] = REINFORCED WITH 1 STEEL BAR PART NUMBER 28
- [R2] = REINFORCED WITH 2 STEEL BARS PART NUMBER 28
- [R3] = REINFORCED WITH 3 STEEL CHANNELS PART NUMBERS 29, 30 & 31


SEE PARTS DRAWINGS & PARTS LIST FOR APPLICABLE REINFORCEMENT MEMBERS & THEIR DETAIL.

PRODUCT REVISED
as complying with the Florida
Building Code
Acceptance No. 14-0430.34
Expiration Date 08/08/2018
By *[Signature]*
Miami Dade Product Control


Approved as complying with the
Florida Building Code
Date 08/08/2018
NOA# 13-052213
Miami Dade Product Control
By *[Signature]*

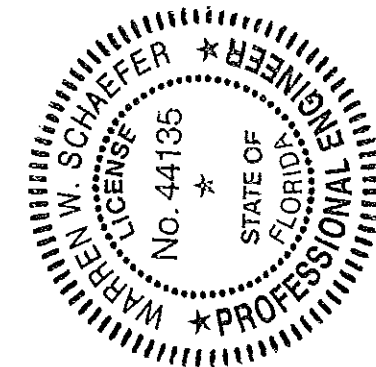

| | |
|---|-----------------------|
| DRAWN BY: W.R.V. | CHECKED BY: W.W.S. |
| PLOT: 1-48 | DATE: 01/15/13 |
| DATE | |
| BY | |
| REVISION DESCRIPTION | |
| NO. | |
| DRAWING TITLE: 8 13/16" DEEP 1630-SS-IR DRY GLAZED SMI CURTAIN WALL | |
| MANUFACTURER: KAWNEER COMPANY, INC. 555 GUTHRIE COURT NORCROSS, GA 30092 770-449-5555 | |
| CONSULTANTS: W. W. SCHAEFER ENGINEERING & CONSULTING, P.A. (CA 6809) 7480 150TH COURT NORTH PALM BEACH GARDENS, FL 33418 PHONE: 561-744-3424 | |
| CERTIFICATION: APR 02 2013 | |
| DRAWING NO. 1848 | REV. |
| SHEET NO. 2 OF 21 | |

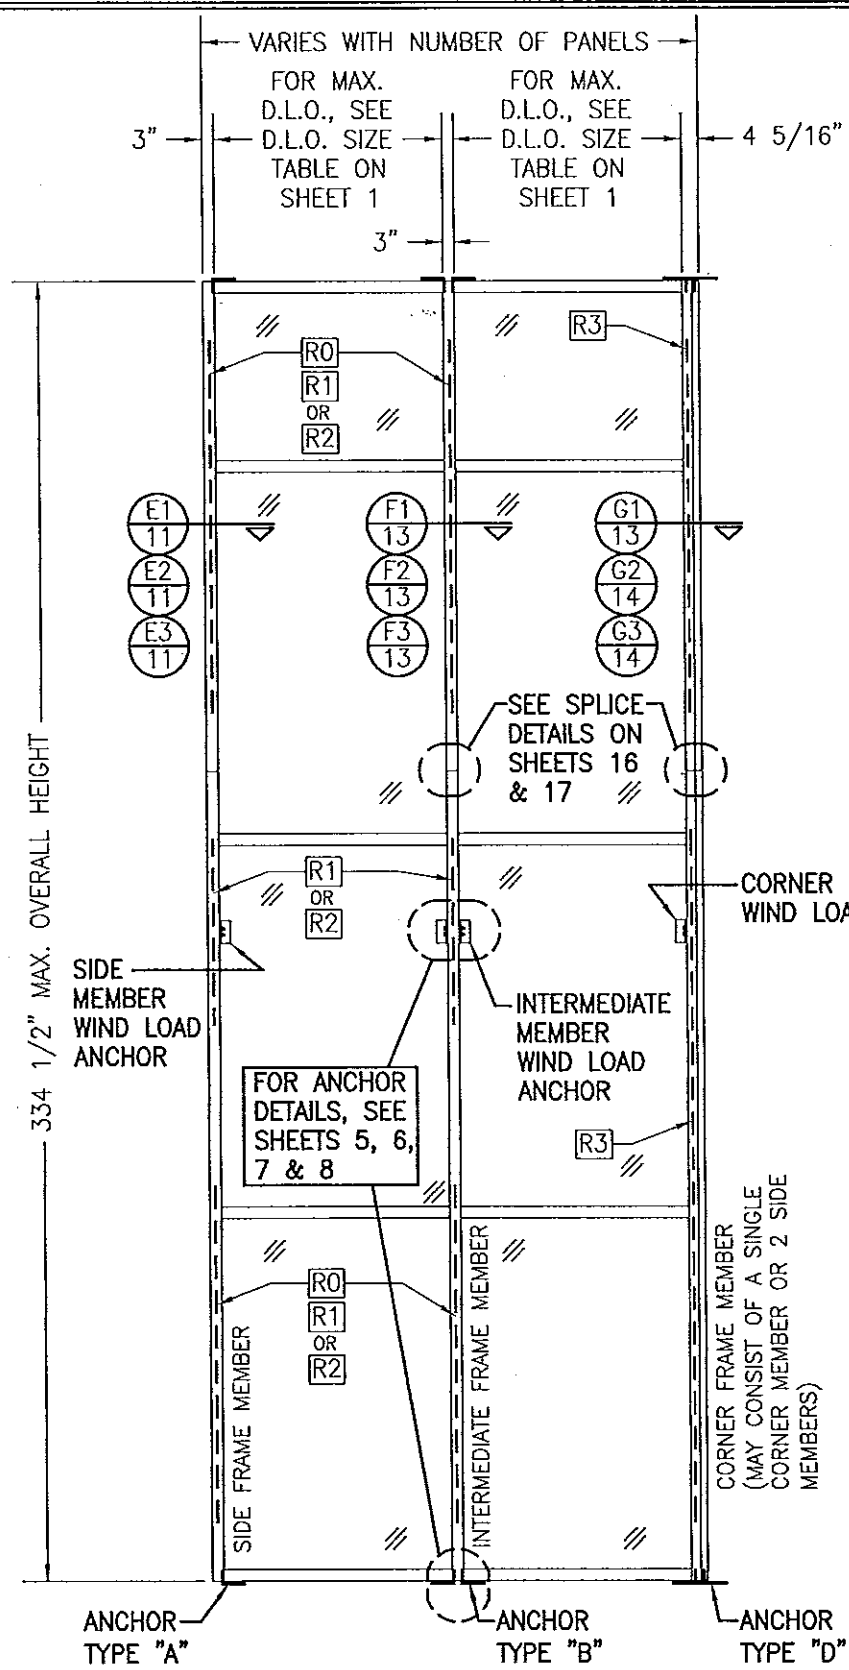

EXTERIOR ELEVATION VIEW "A-A":
MULTI-SPAN CURTAIN WALL
SCALE: 1/4" = 1'-0"

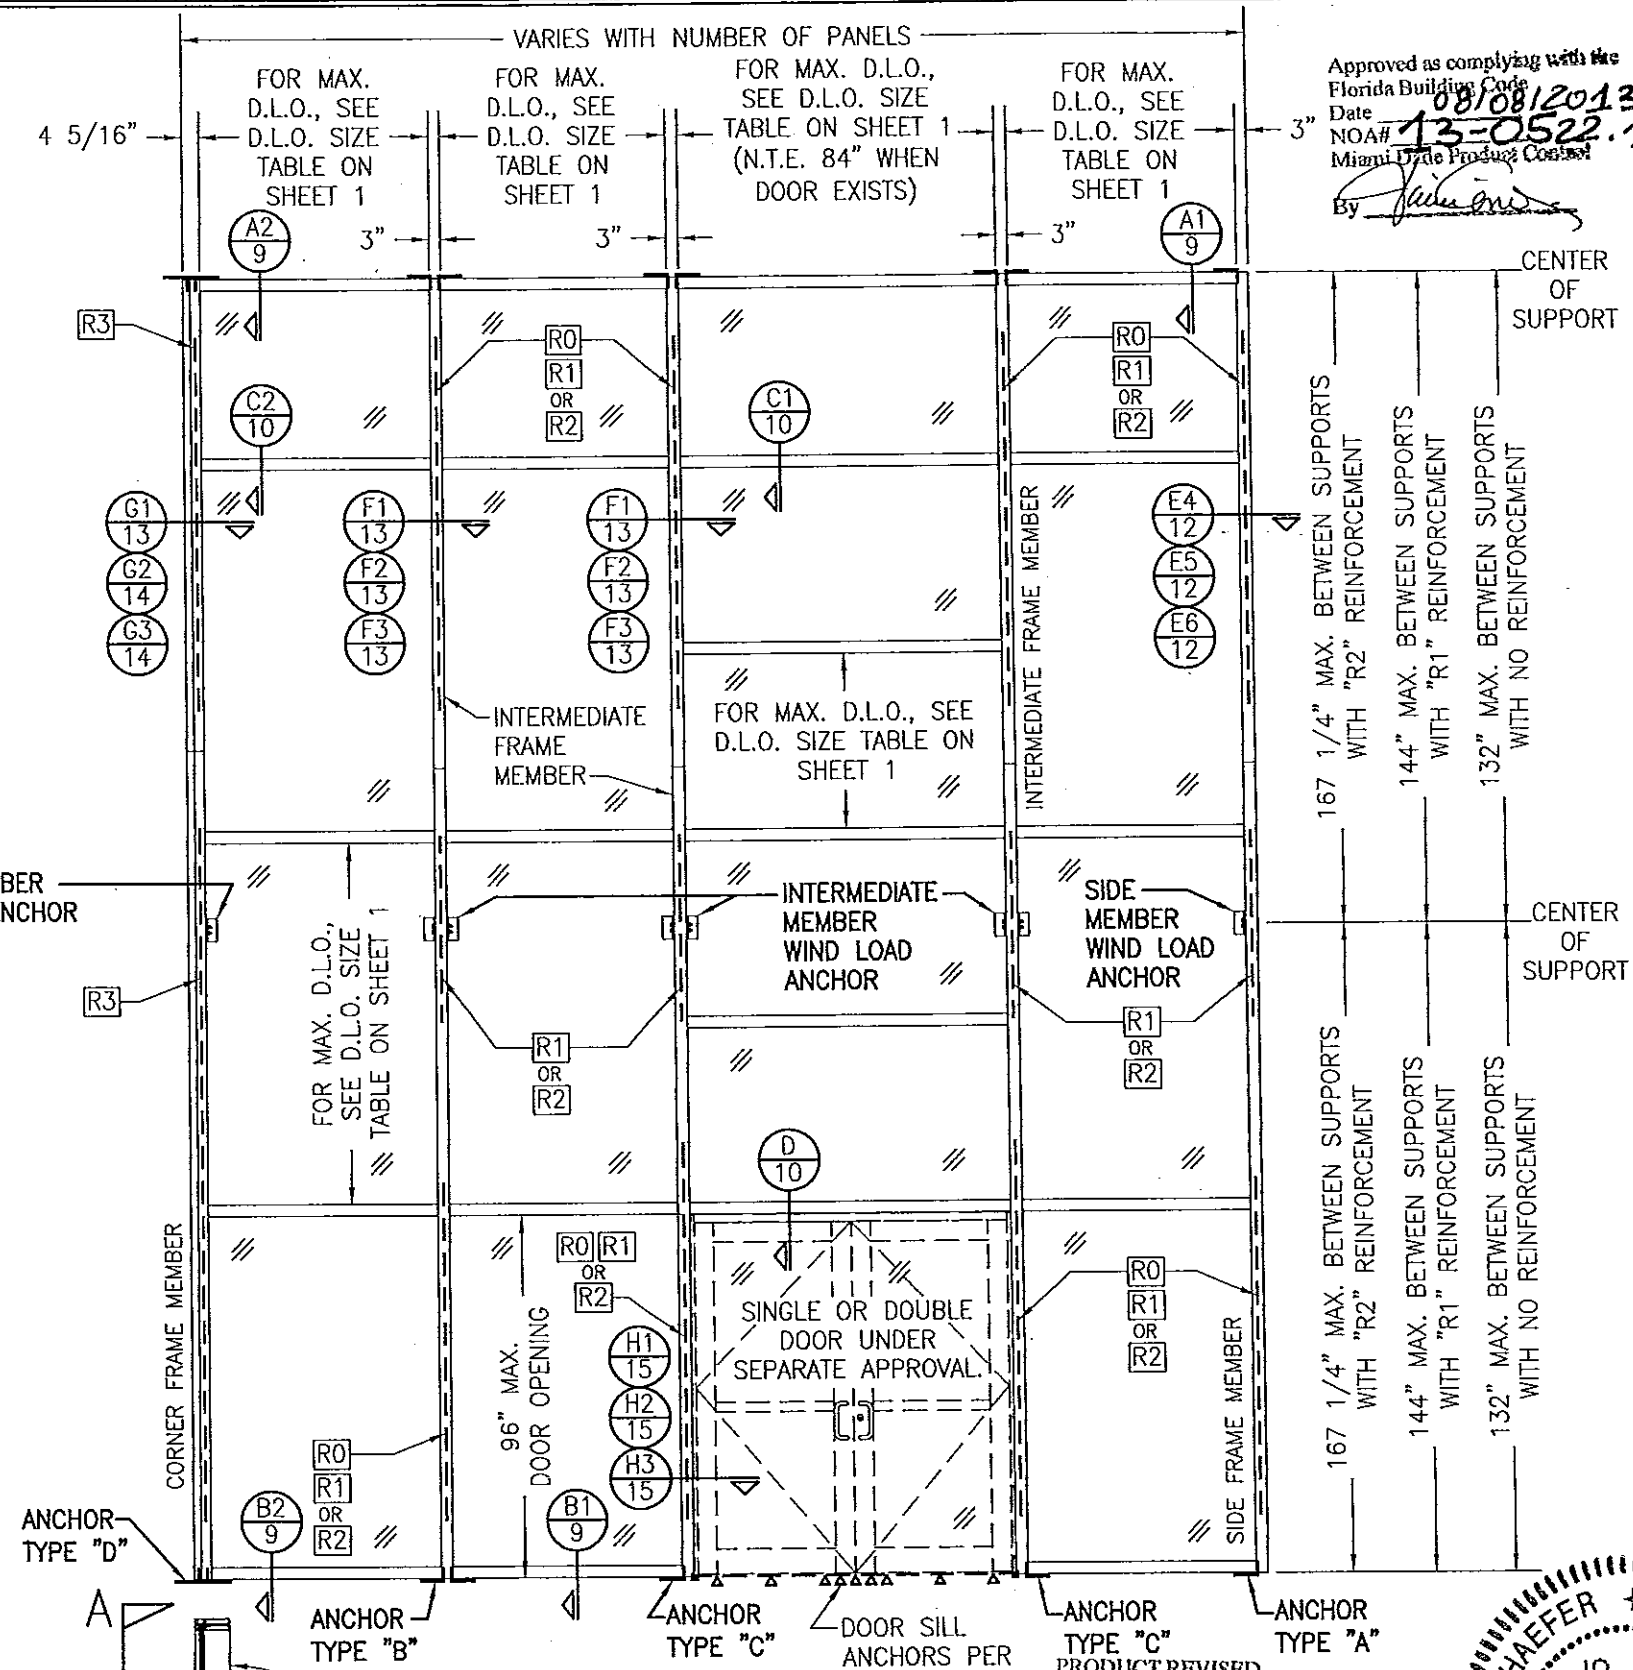


EXTERIOR ELEVATION VIEW "B-B":
MULTI-SPAN CURTAIN WALL
SCALE: 1/4" = 1'-0"


PLAN VIEW:
MULTI-SPAN CURTAIN WALL
SCALE: 1/4" = 1'-0"

VERTICAL FRAME MEMBER END ANCHOR NOTE:
END ANCHORS AT THE TOP ENDS MAY BE TYPES "A", "B" OR "D" AS SPECIFIED AT THE BASE OR THEY MAY BE SUBSTITUTED WITH WIND LOAD ANCHORS. IF WIND LOAD ANCHORS ARE USED, THEY MUST BE POSITIONED SUCH THAT THE WIND LOAD ANCHOR TOP EDGE IS NO MORE THAN 6" DOWN FROM THE VERTICAL MEMBER END.


Approved as complying with the
Florida Building Code
Date 08/08/2013
NOAH# 13-0522.13
Miami Trade Product Control
By [Signature]

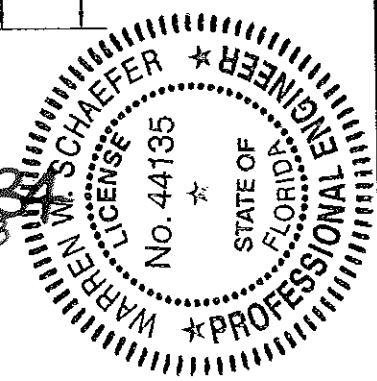

| | |
|--|--|
| DRAWN BY: W.R.M. | CHECKED BY: W.W.S. |
| PLOT: 1-48 | DATE: 01/15/13 |
| DATE | BY |
| REVISION DESCRIPTION | NO. |
| DRAWING TITLE 8 13/16" DEEP 1630-SS-IR DRY GLAZED SMI CURTAIN WALL | |
| MANUFACTURER KAWNEER COMPANY, INC. 555 GUTHRIE COURT NORCROSS, GA 30092 770-449-5555 | |
| CONSULTANTS W. W. SCHAEFER ENGINEERING & CONSULTING, P.A. (CA 6809) 7480 150TH COURT NORTH PALM BEACH GARDENS, FL 33418 PHONE: 561-744-3424 | |
| CERTIFICATION APR 02 2013 | WARREN W. SCHAEFER, P.E. P.E. NO. 44135 |
| DRAWING NO. 1848 | REV. |
| SHEET NO. 3 | OF 21 |


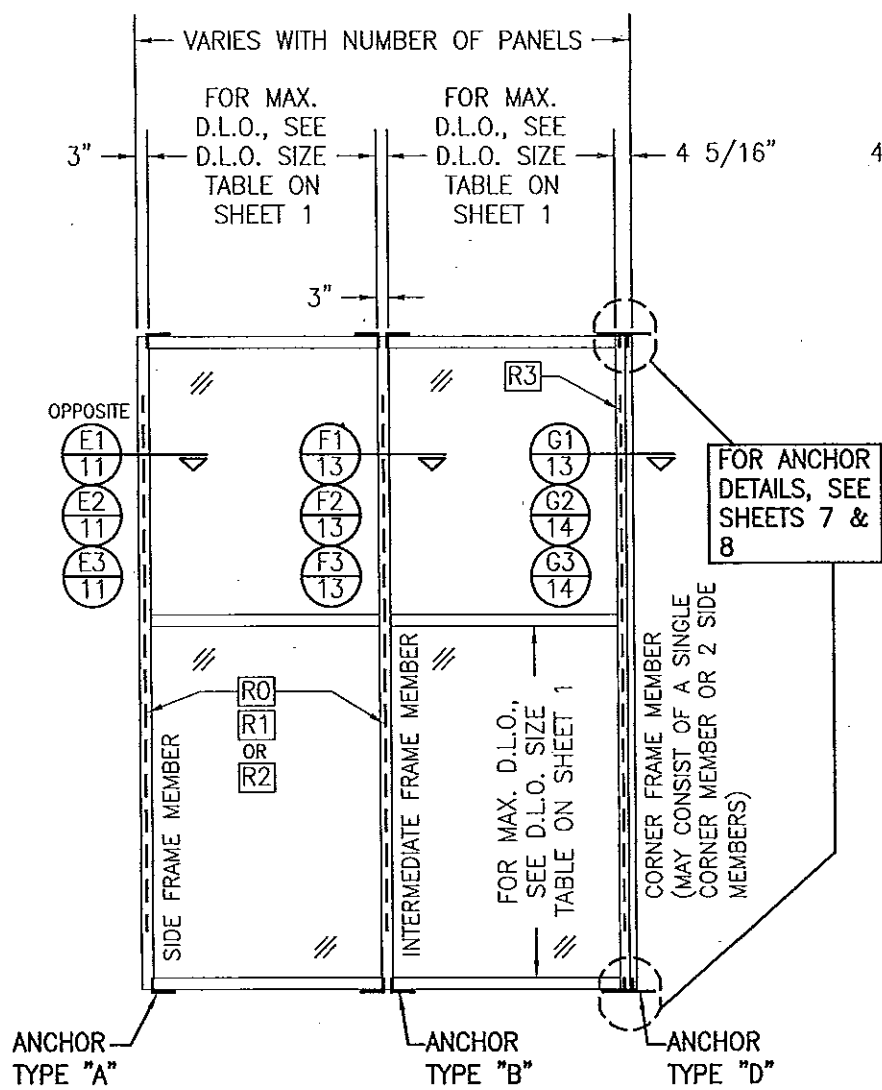


EXTERIOR ELEVATION VIEW "A-A":
SINGLE-SPAN CURTAIN WALL
SCALE: 1/4" = 1'-0"

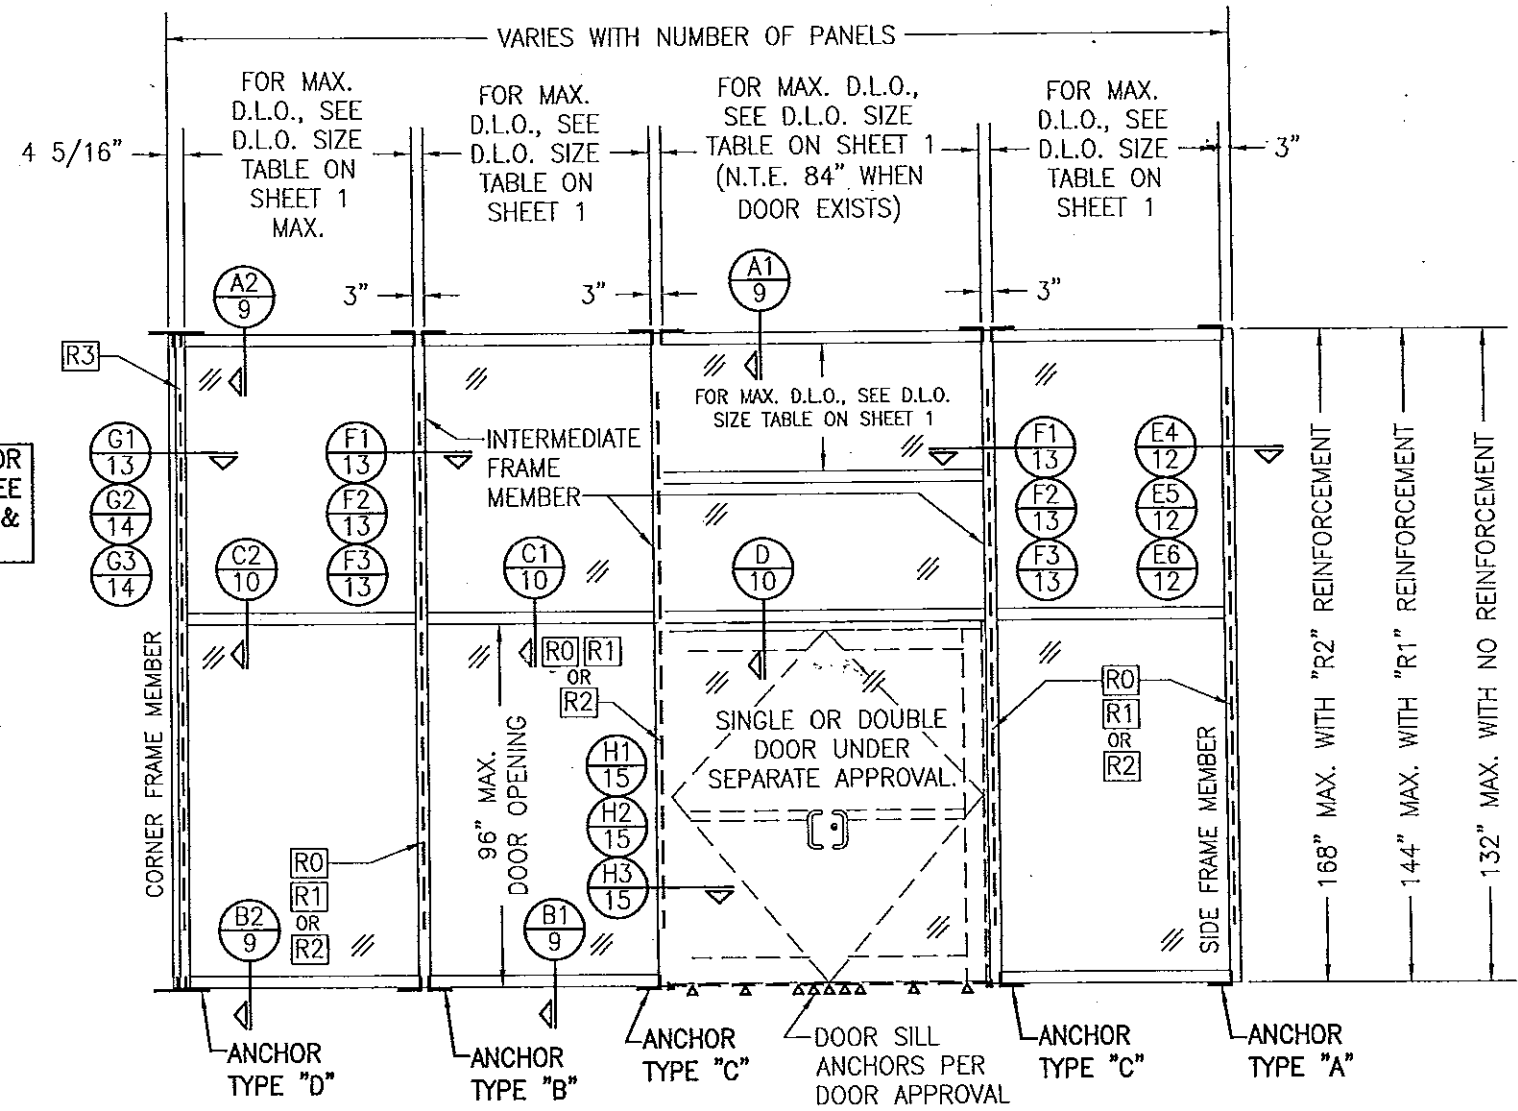

EXTERIOR ELEVATION VIEW "B-B":
SINGLE-SPAN CURTAIN WALL
SCALE: 1/4" = 1'-0"


VERTICAL FRAME MEMBER END ANCHOR NOTE:
END ANCHORS AT THE TOP ENDS MAY BE TYPES "A", "B" OR "D" AS SPECIFIED AT THE BASE OR THEY MAY BE SUBSTITUTED WITH WIND LOAD ANCHORS. IF WIND LOAD ANCHORS ARE USED, THEY MUST BE POSITIONED SUCH THAT THE WIND LOAD ANCHOR TOP EDGE IS NO MORE THAN 6" DOWN FROM THE VERTICAL MEMBER END.

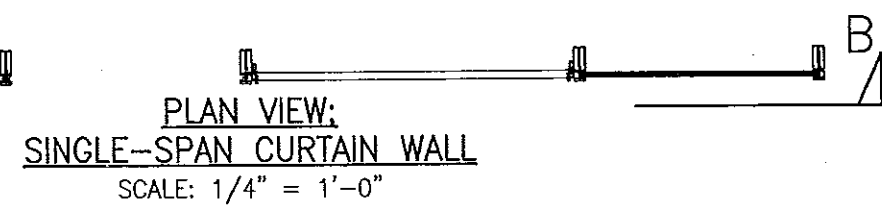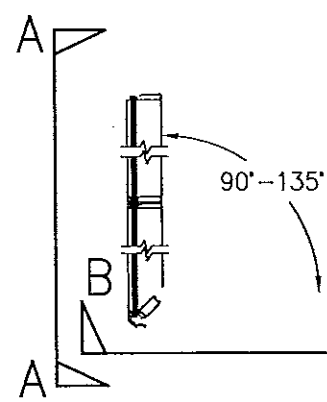



PLAN VIEW:
SINGLE-SPAN CURTAIN WALL
SCALE: 1/4" = 1'-0"

PRODUCT REVISED
as complying with the Florida
Building Code
Acceptance No. 14-0430.34
Expiration Date 08/16/2018
By [Signature]
Miami Dade Product Control

Approved as complying with the
Florida Building Code
Date 08/16/2013
NOA# 13-0522.13
Miami Dade Product Control
By [Signature]

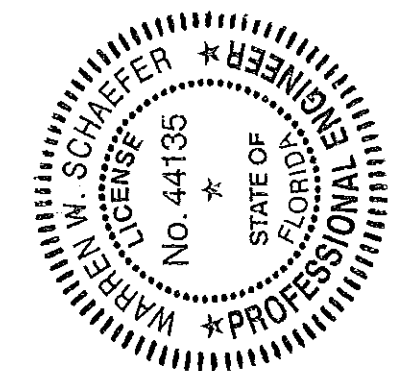

| | | | |
|--|------------------|---|-----|
| DRAWN BY: W.R.M. | | CHECKED BY: W.W.S. | |
| PLOT: 1=48 | | DATE: 01/15/13 | |
| DATE | BY | REVISION DESCRIPTION | NO. |
| | | | |
| DRAWING TITLE: 8 13/16" DEEP 1630-SS-IR DRY GLAZED SMI CURTAIN WALL | | | |
| CONSULTANTS: W. W. SCHAEFER ENGINEERING & CONSULTING, P.A. (CA 6809) | | MANUFACTURER: KAWNEER COMPANY, INC. | |
| 7480 150TH COURT NORTH, PALM BEACH GARDENS, FL 33418 | | 555 GUTHRIDGE COURT, NORCROSS, GA 30092 | |
| PHONE: 561-744-3424 | | 770-449-5555 | |
| CERTIFICATION: APR 02 2013 | DRAWING NO. 1848 | | |
| SHEET NO. 4 | | REV. 21 | |

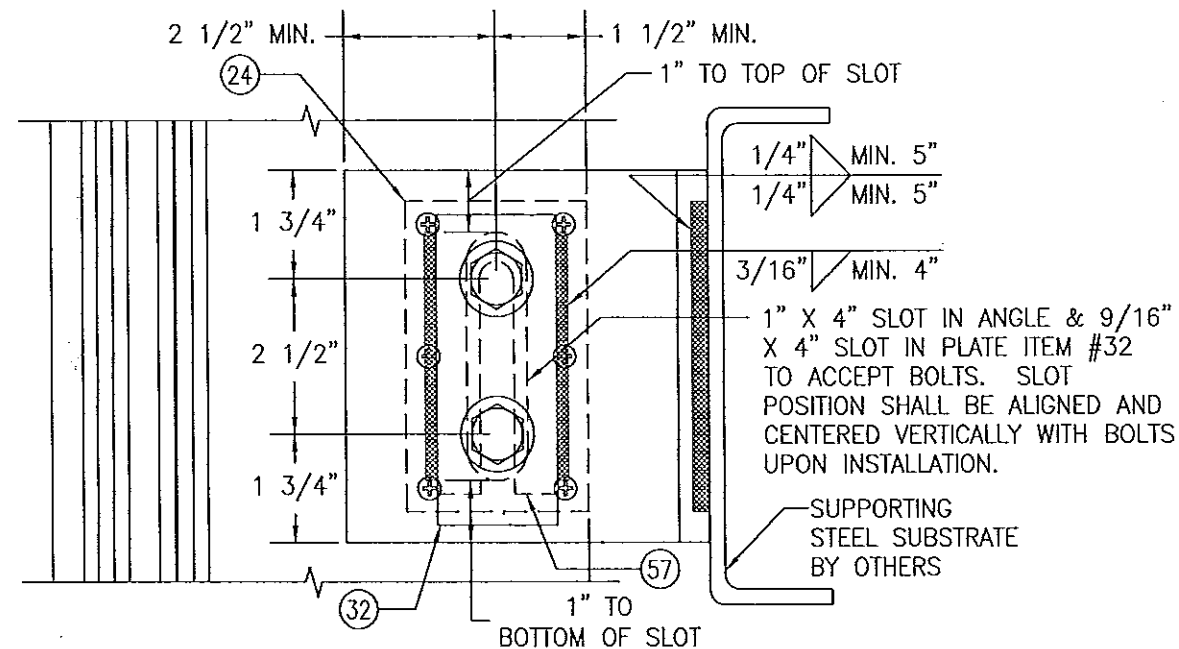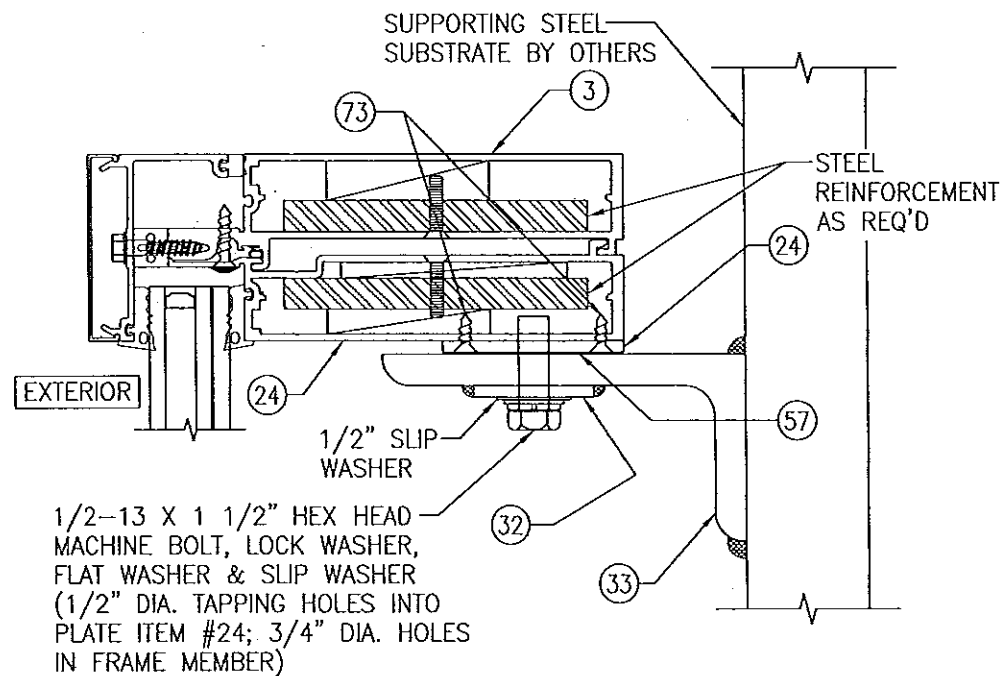

STANDARD WIND LOAD ANCHOR AT SIDE MEMBERS



SCALE: 1/3 FULL

(FOR INFORMATION NOT SHOWN, SEE APPLICABLE SECTIONS E1/11 THROUGH E6/12.)

NOTE: ALL 1/2" BOLTS CONNECTING ANGLES TO MEMBERS SHALL BE GRADE 5 STEEL OR 300 SERIES STAINLESS STEEL.

PRODUCT REVISED as complying with the Florida Building Code
 Date 08/08/2013
 Acceptance No. 14-0430.34
 Expiration Date 08/08/2018

By Warren W. Schaefer
 Miami Dade Product Control

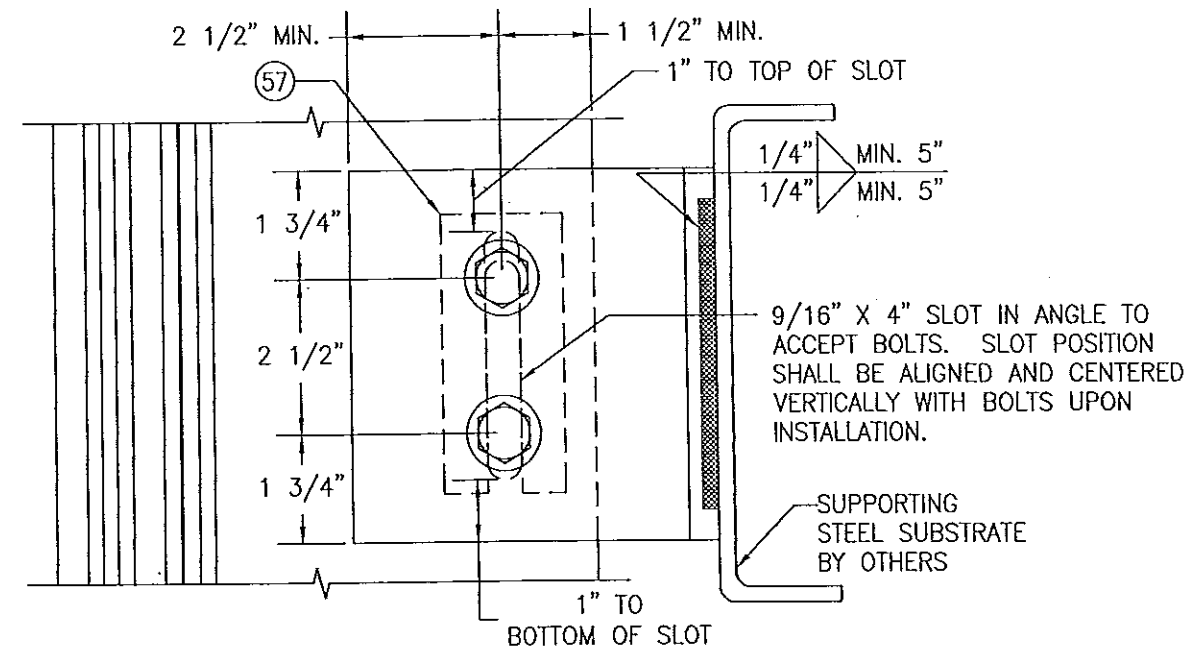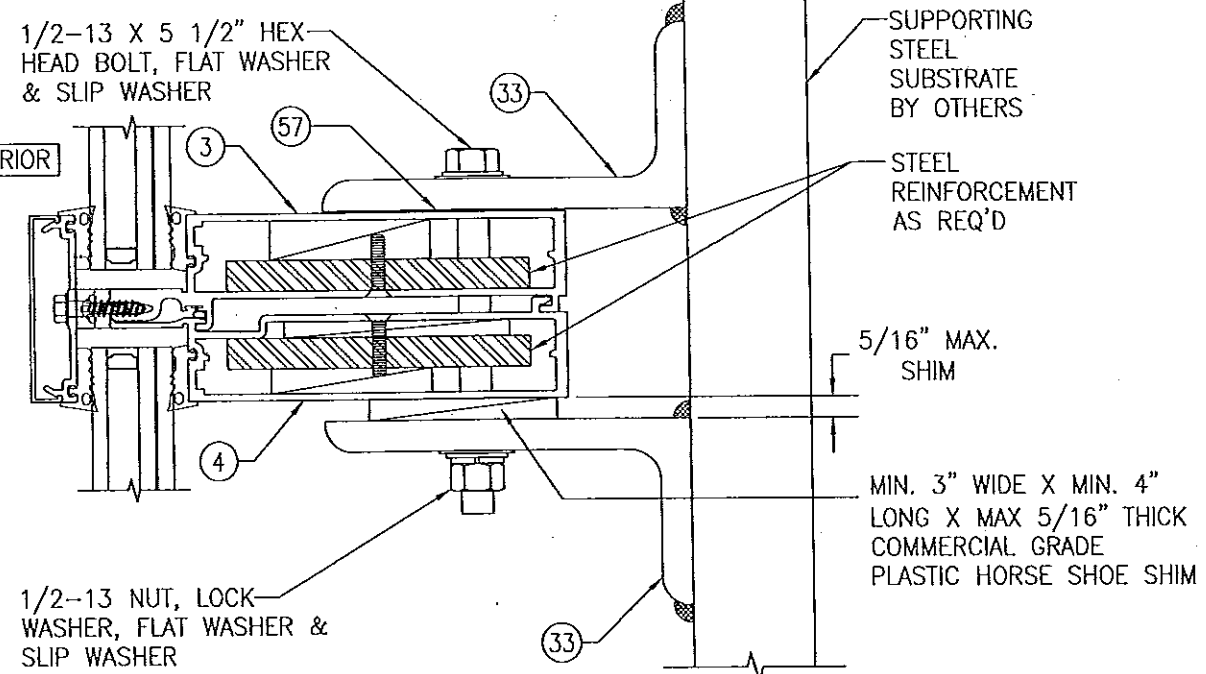


STANDARD WIND LOAD ANCHOR AT INTERMEDIATE MEMBERS

SCALE: 1/3 FULL


(FOR INFORMATION NOT SHOWN, SEE APPLICABLE SECTIONS F1/13 THROUGH F3/13.)

Approved as complying with the Florida Building Code
 Date 08/08/2013
 NOA# 13-522.13
 Miami Dade Product Control


By Warren W. Schaefer
 Miami Dade Product Control

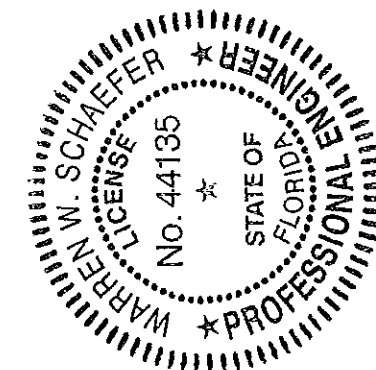


| | | | |
|---|-------------|---|-----|
| DRAWN BY: W.R.V. | | CHECKED BY: W.W.S. | |
| PLOT: 1-3 | | DATE: 01/15/13 | |
| DATE | BY | REVISION DESCRIPTION | NO. |
| | | | |
| DRAWING TITLE: 8 13/16" DEEP 1630-SS-IR DRY GLAZED SMI CURTAIN WALL | | | |
| CONSULTANTS | | MANUFACTURER | |
| W. W. SCHAEFER ENGINEERING & CONSULTING, P.A. (CA 6809) | | KAWNEER COMPANY, INC. | |
| 7480 150TH COURT NORTH PALM BEACH GARDENS, FL 33418 PHONE: 561-744-3424 | | 555 GUTHRIE COURT NORCROSS, GA 30092 770-449-5555 | |
| CERTIFICATION | APR 02 2013 | WARREN W. SCHAEFER, P.E. P.E. NO. 44135 | |
| DRAWING NO. 1848 | | REV. | |
| SHEET NO. 5 | | OF 21 | |

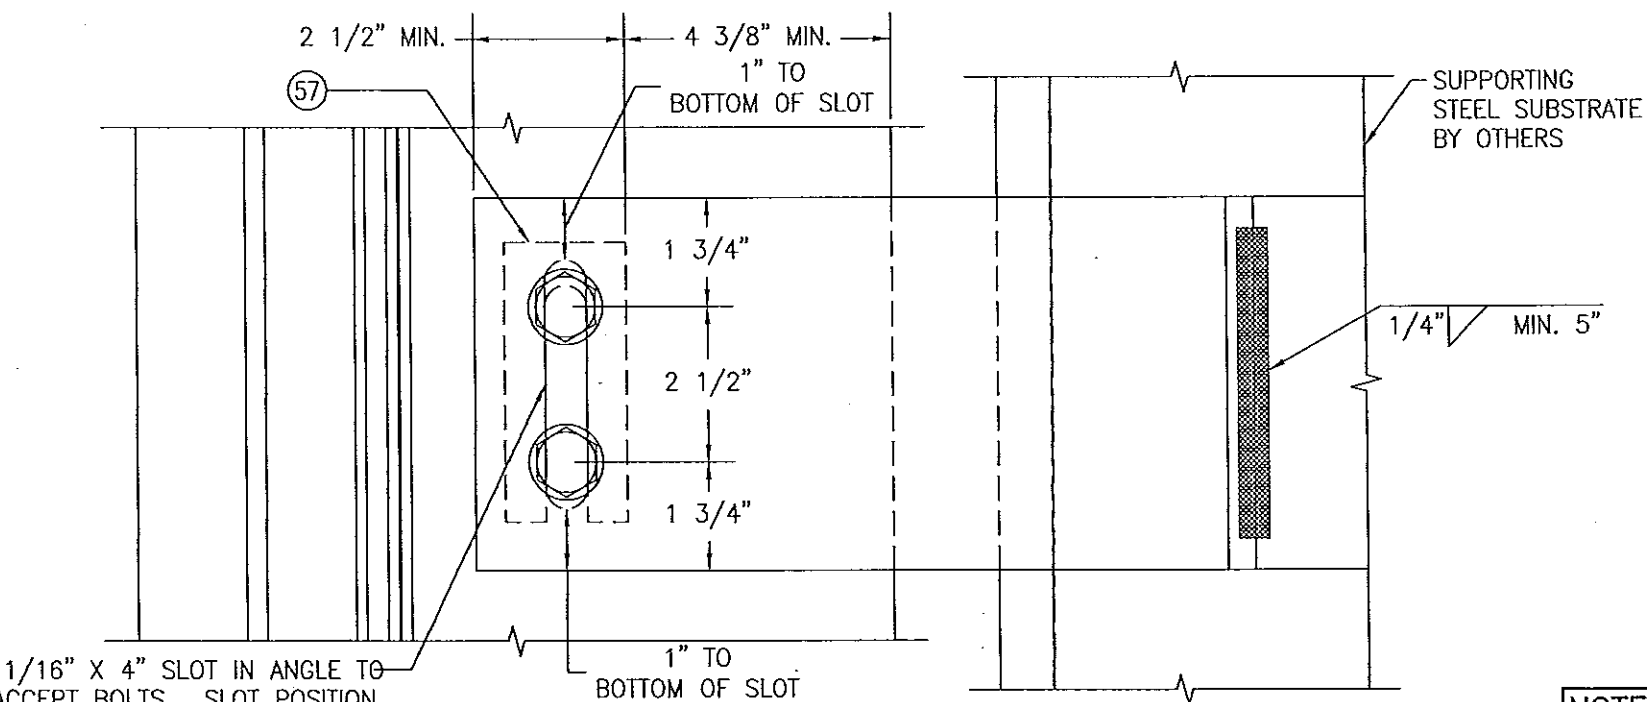


A circular professional engineer seal for Warren W. Schaefer. The outer ring contains the text "WARREN W. SCHAEFER" at the top and "PROFESSIONAL ENGINEER" at the bottom, separated by stars. The inner circle contains the text "LICENSE" on the left, "NO. 44135" in the center, and "STATE OF FLORIDA" on the right, also separated by stars. The seal is surrounded by a decorative border of small vertical lines.


| | | | | | | | | | |
|----------------------------|------------------------------------|---|--|----------------------|---|------|---|--|--|
| DRAWING NO. 1848 | SHEET NO. 6 OF 21 | <div>CERTIFICATION APR 02 2003 </div> | DRAWING TITLE 8 13/16" DEEP 1630-SS-IR DRY GLAZED SMI CURTAIN WALL | | CONSULTANTS W. W. SCHAEFER ENGINEERING & CONSULTING, P.A. (CA 6809) 7480 150TH COURT NORTH PALM BEACH GARDENS, FL 33418 | | MANUFACTURER KAWNEER COMPANY, INC. 555 GUTHRIDGE COURT NORCROSS, GA 30092 770-449-5555 | | |
| | | | NO. | REVISION DESCRIPTION | BY | DATE | | | |
| | | | | | | | | | |
| | | | | | | | | | |
| | | | | | | | | | |
| | | | | | | | | | |

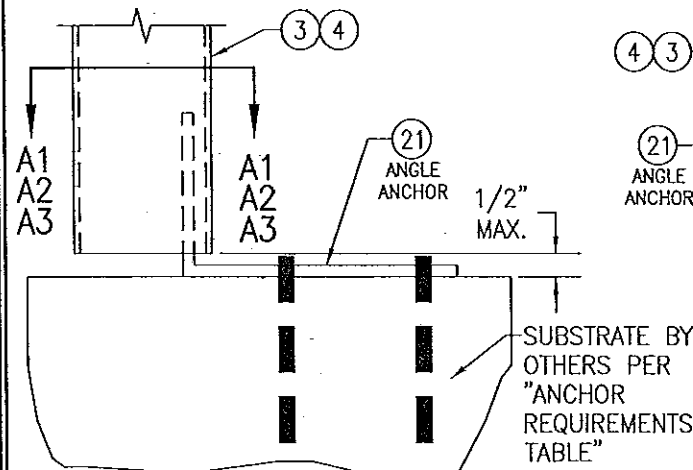


SIDE MEMBER ANCHOR TYPE "A"
SCALE: 1/4 FULL

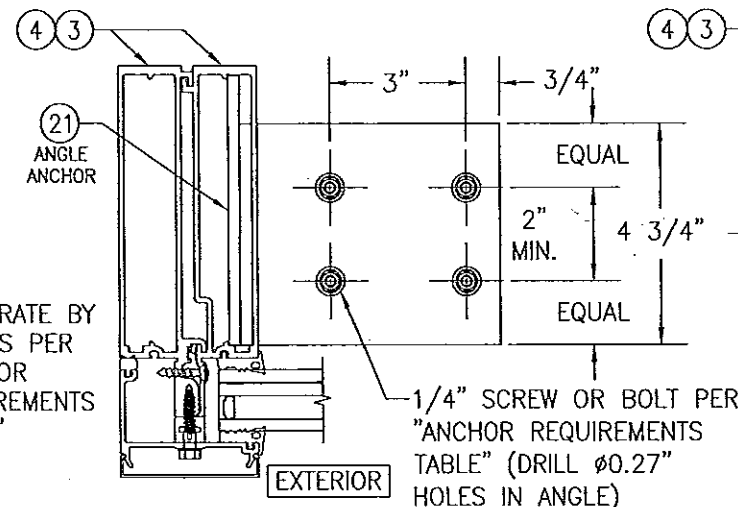


SECTION "A1" (INTO WOOD, CONCRETE, STEEL, METAL STUD OR ALUMINUM)
SCALE: 1/4 FULL
(REINFORCEMENT NOT SHOWN FOR CLARITY, REINFORCE AS REQ'D)

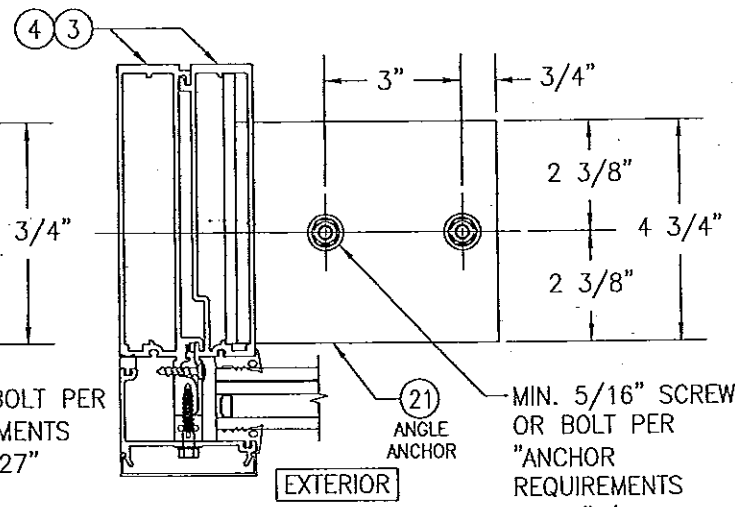


SECTION "A2" (INTO STEEL)
SCALE: 1/4 FULL

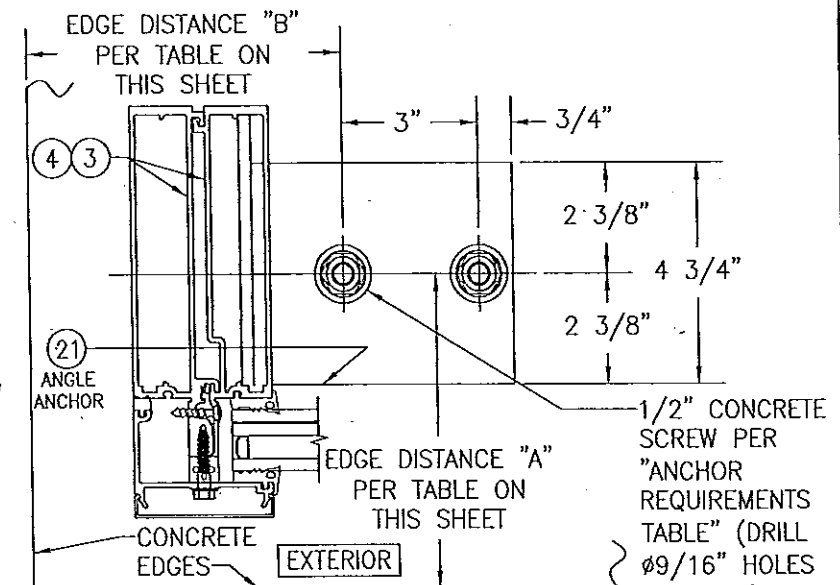


SECTION "A3" (INTO CONCRETE)
SCALE: 1/4 FULL

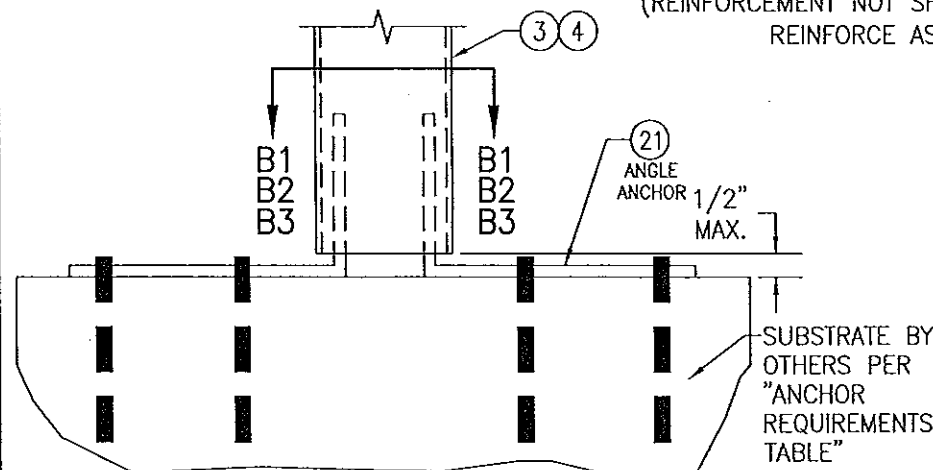


INTERMEDIATE MEMBER ANCHOR TYPE "B"
SCALE: 1/4 FULL

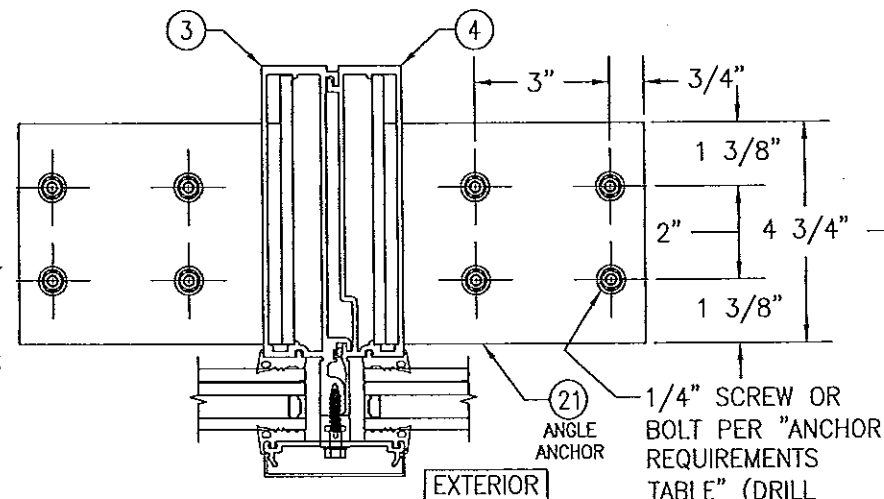

SECTION "B1" (INTO WOOD, METAL STUD & ALUMINUM)
SCALE: 1/4 FULL

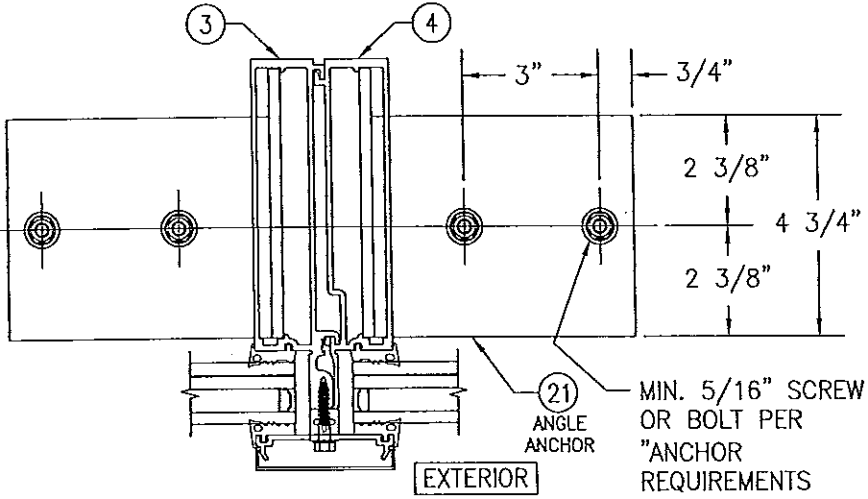

SECTION "B2" (INTO STEEL)
SCALE: 1/4 FULL

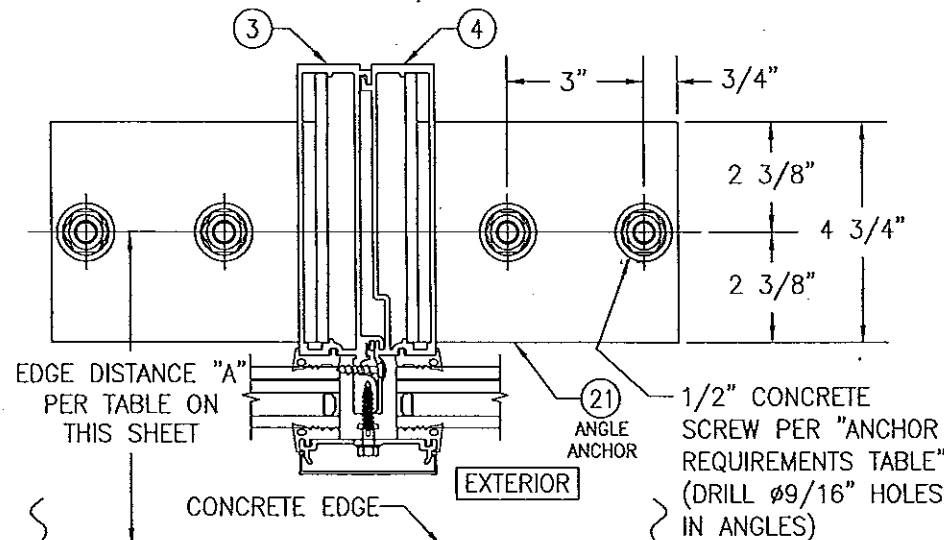


SECTION "B3" (INTO CONCRETE)
SCALE: 1/4 FULL


| CONCRETE EDGE DISTANCE & THICKNESS REQUIREMENTS | | | |
|---|------------------------|------------------------|------------------------|
| SECTION | MINIMUM SLAB THICKNESS | MINIMUM EDGE DIST. "A" | MINIMUM EDGE DIST. "B" |
| "A3" | 6" | 5" | 4 1/2" |
| "B3" | 7 1/2" | 5" | N/A |
| | 6" | 6" | N/A |

PRODUCT REVISED
as complying with the Florida
Building Code
Acceptance No. 14-0430.3A
Expiration Date 08/08/2018
By [Signature]
Miami Dade Product Control


Approved as complying with the
Florida Building Code
Date 08/08/2013
NOA# 13-0522.13
Miami Dade Product Control
By [Signature]

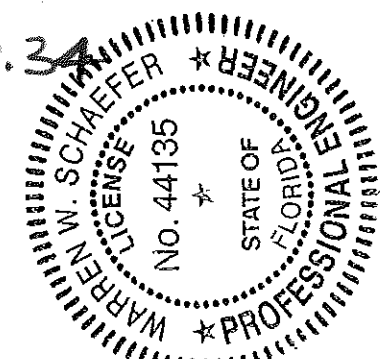


| | | | | | |
|--|----------|---------------------|---|-----------------------|--|
| DRAWING TITLE 8 13/16" DEEP 1630-SS-IR DRY GLAZED SMI CURTAIN WALL | | DRAWN BY: W.R.M. | | CHECKED BY: W.W.S. | |
| PLOT: 1=4 | | DATE: 01/15/13 | | | |
| NO. | REVISION | DESCRIPTION | BY | DATE | |
| | | | | | |
| CONSULTANTS W. W. SCHAEFER ENGINEERING & CONSULTING, P.A. (CA 6809) 7480 150TH COURT NORTH PALM BEACH GARDENS, FL 33418 PHONE: 561-744-3424 | | | MANUFACTURER KAWNEER COMPANY, INC. 555 GUTHRIE COURT NORCROSS, GA 30092 770-449-5555 | | |
| CERTIFICATION APR 02 2013 | | | WARREN W. SCHAEFER, P.E. P.E. NO. 44135 | | |
| DRAWING NO. 1848 | | | REV. | | |
| SHEET NO. 7 OF 21 | | | | | |

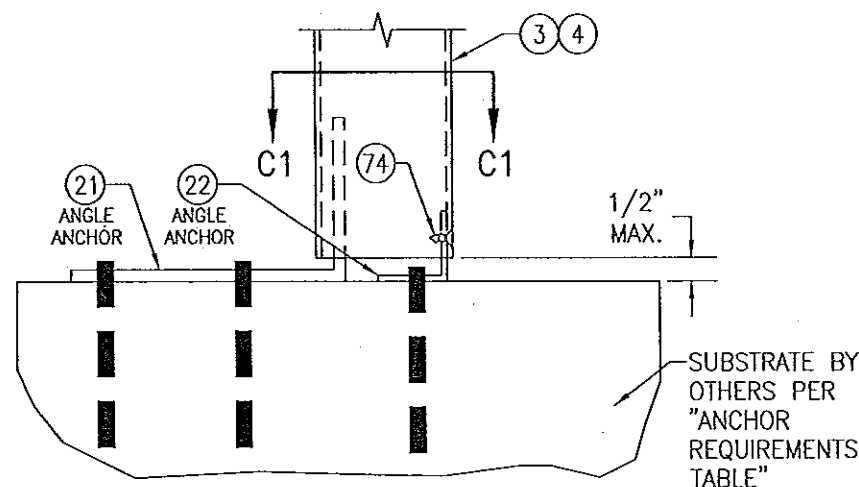


INTERMEDIATE MEMBER ANCHOR TYPE "C"
(APPLICABLE AT BASE OF DOOR OPENINGS)
SCALE: 1/4 FULL

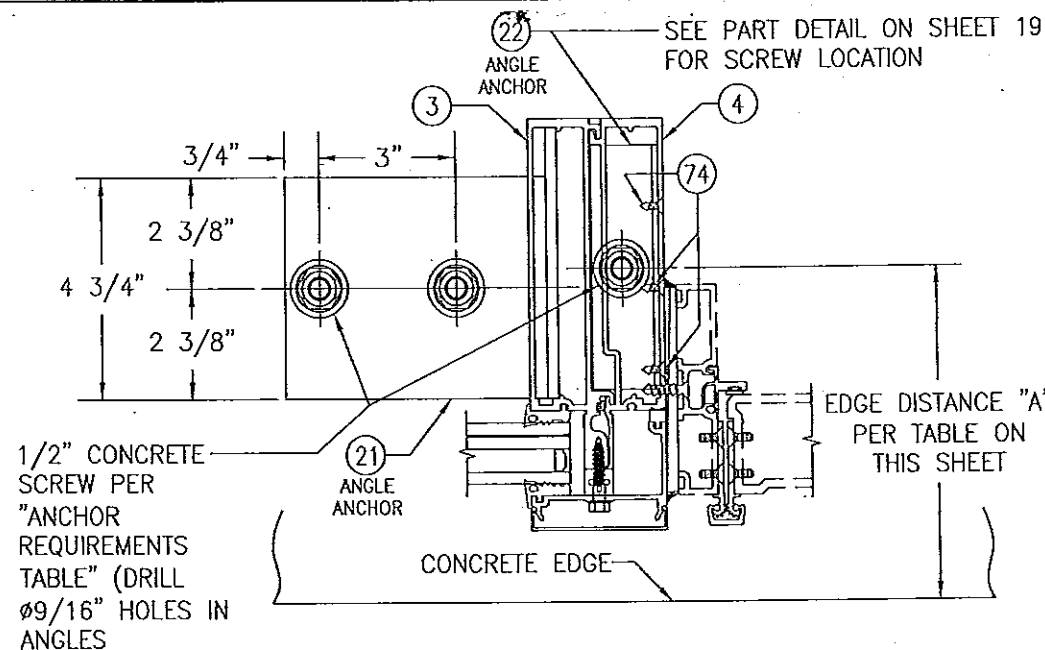


SECTION "C1" (INTO CONCRETE)
SCALE: 1/4 FULL

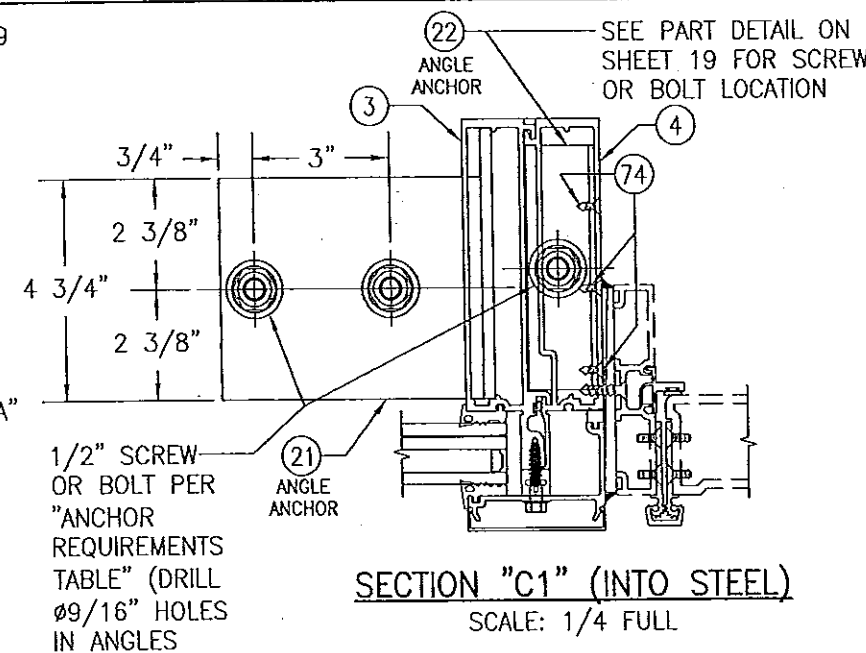


SECTION "C1" (INTO STEEL)
SCALE: 1/4 FULL

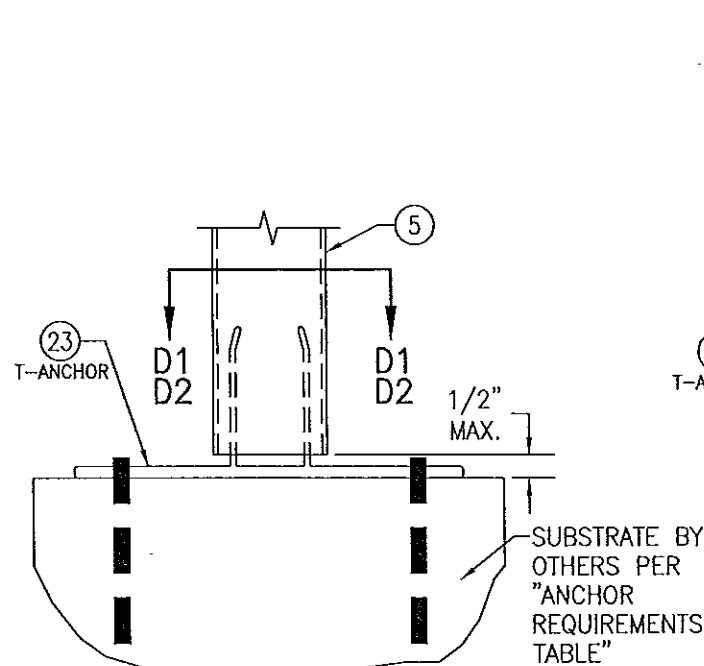

CORNER MEMBER ANCHOR TYPE "D"
SCALE: 1/4 FULL

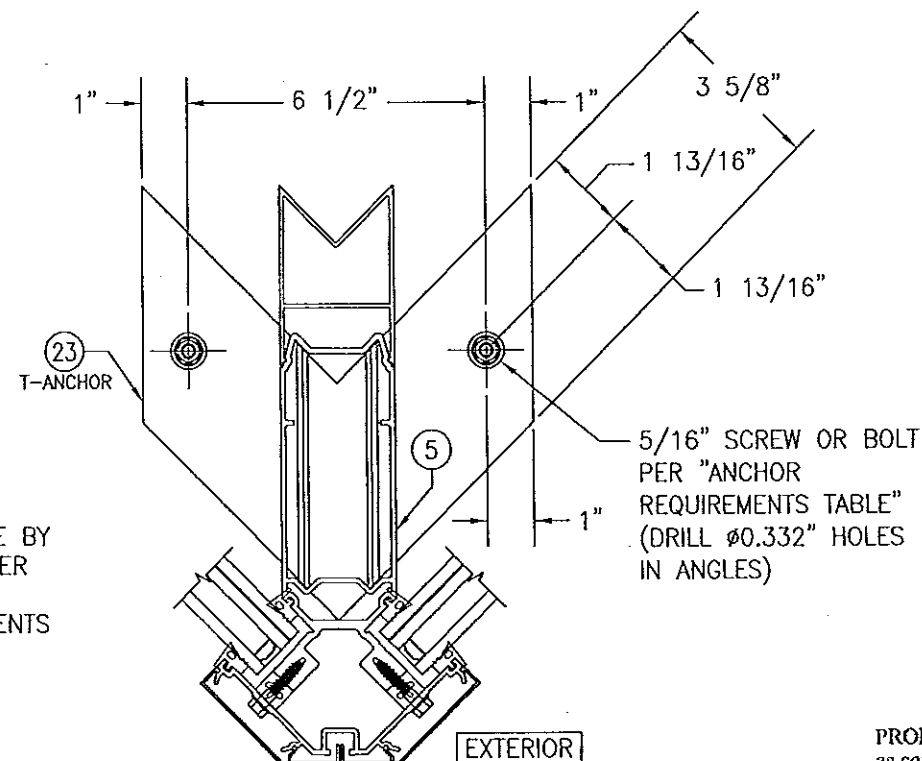

SECTION "D1" (INTO STEEL)
SCALE: 1/4 FULL

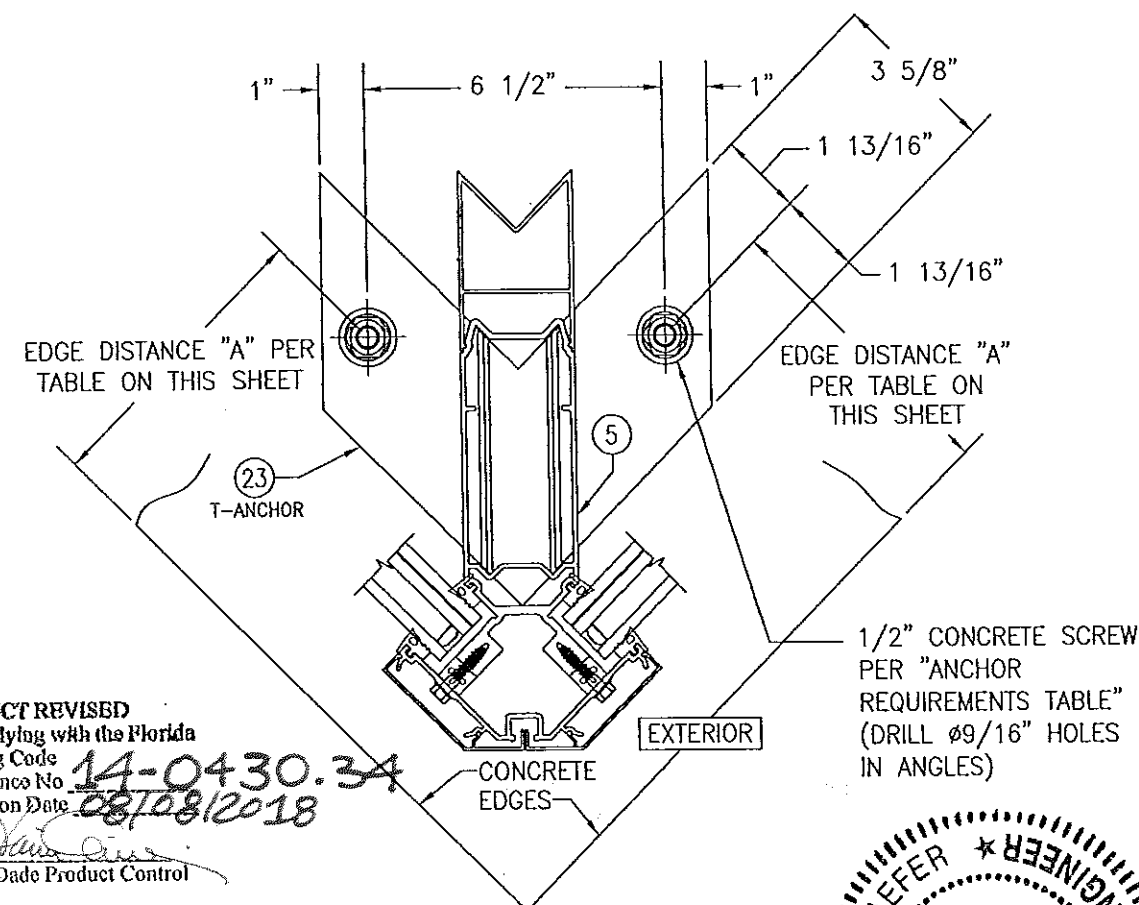


SECTION "D2" (INTO CONCRETE)
SCALE: 1/4 FULL

CONCRETE EDGE DISTANCE & THICKNESS REQUIREMENTS


| SECTION | MINIMUM SLAB THICKNESS | MINIMUM EDGE DIST. "A" |
|---------|------------------------|------------------------|
| "C1" | 7 1/2" | 5 3/4" |
| "D2" | 6" | 5" |

PRODUCT REVISED
as complying with the Florida
Building Code
Acceptance No. 14-0430.34
Expiration Date 08/08/2018
By *[Signature]*
Miami Dade Product Control


Approved as complying with the
Florida Building Code
Date 08/08/2013
NOA# 13-0522.13
Miami Dade Product Control
By *[Signature]*

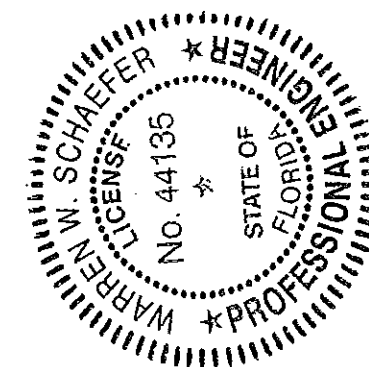


| | | | |
|--|----------|---|------|
| DRAWN BY: W.R.M. | | CHECKED BY: W.W.S. | |
| PLOT: 1=4 | | DATE: 01/15/13 | |
| NO. | REVISION | DESCRIPTION | DATE |
| | | | |
| DRAWING TITLE: 8 13/16" DEEP 1630-SS-IR DRY GLAZED SMI CURTAIN WALL | | | |
| CONSULTANTS: W. W. SCHAEFER ENGINEERING & CONSULTING, P.A. (CA 6809) 7480 150TH COURT NORTH PALM BEACH GARDENS, FL 33418 PHONE: 561-744-3424 | | MANUFACTURER: KAWNEER COMPANY, INC. 555 GUTHRIE COURT NORCROSS, GA 30092 770-449-5555 | |
| CERTIFICATION: APR 0 2 2013 | | P.E. NO. 44135 WARREN W. SCHAEFER, P.E. | |
| DRAWING NO. 1848 | | REV. 21 | |

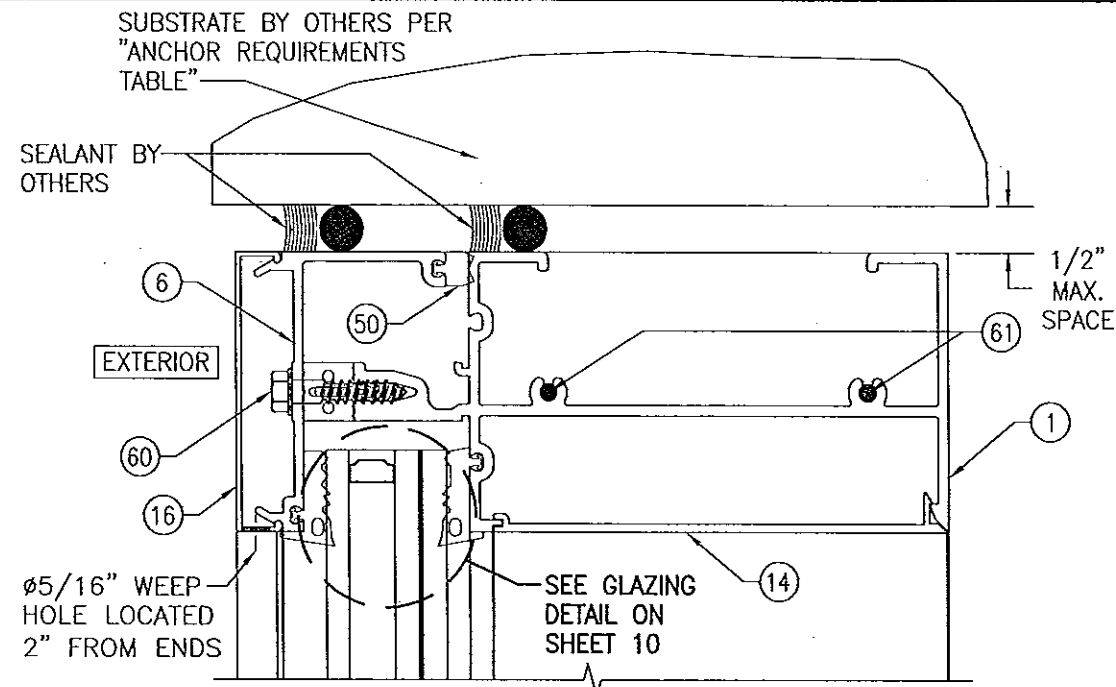


SECTION A1
SCALE: 1/2 FULL

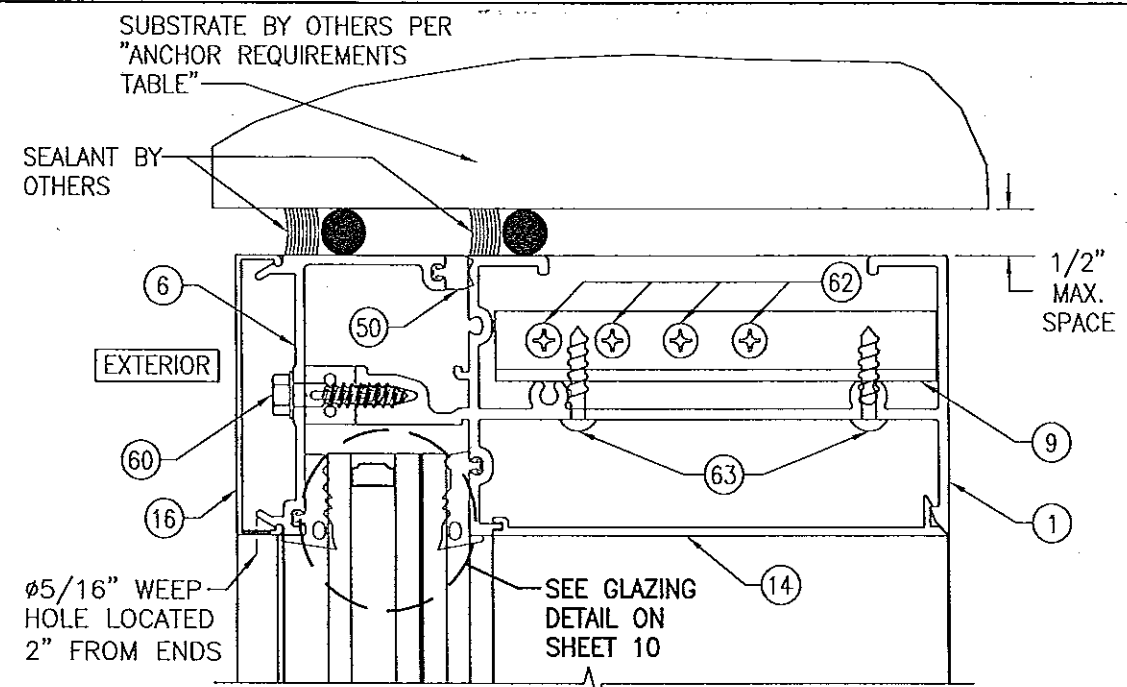

SECTION A2
SCALE: 1/2 FULL

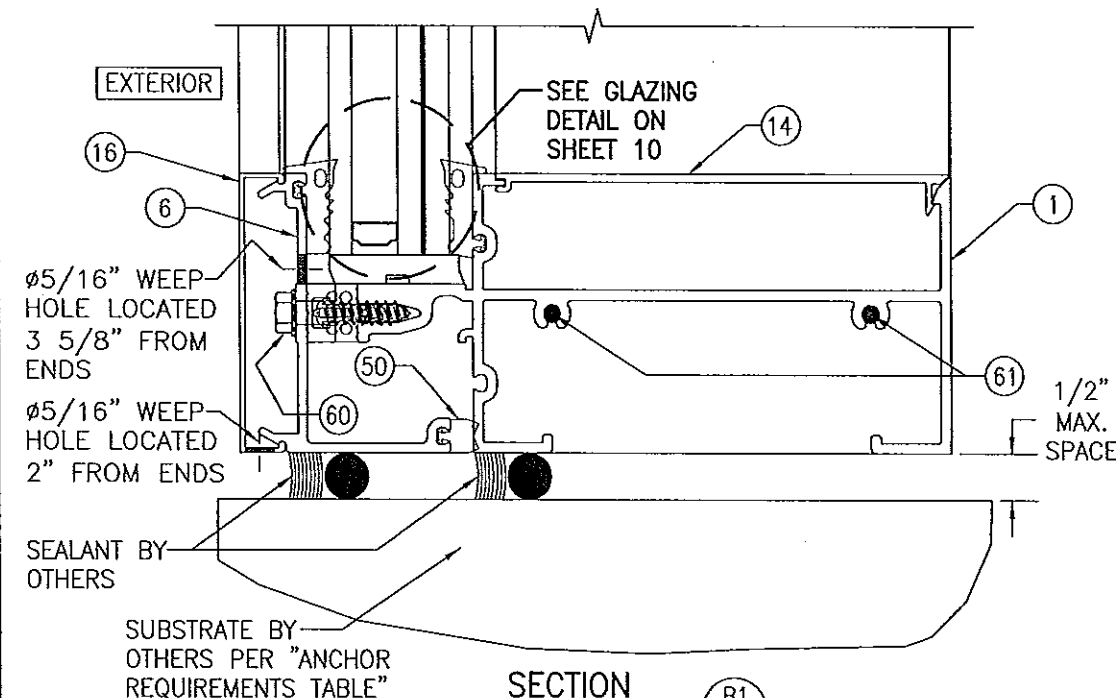


SECTION B1
SCALE: 1/2 FULL

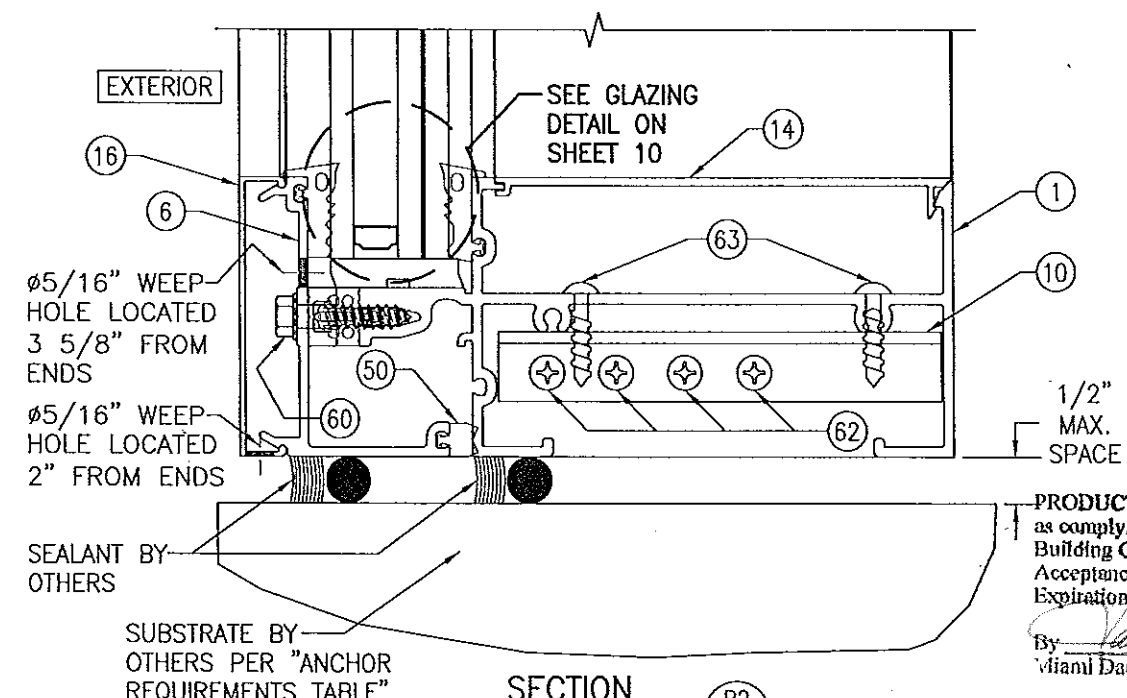


SECTION B2
SCALE: 1/2 FULL

PRODUCT REVISED
as complying with the Florida
Building Code
Acceptance No. 14-0430.34
Expiration Date 08/08/2018
By *Warren W. Schaefer*
Miami Dade Product Control


Approved as complying with the
Florida Building Code
Date 08/08/2013
NOA# 13-0522.13
Miami Dade Product Control
By *Warren W. Schaefer*

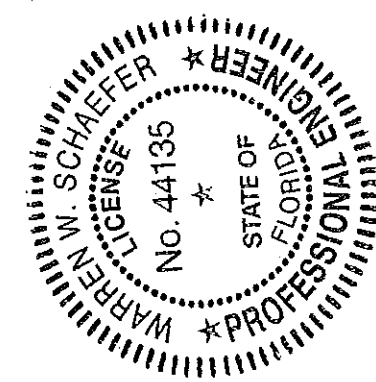


| | |
|---|--|
| DRAWN BY: W.R.M. | CHECKED BY: W.W.S. |
| PLOT: 1=2 | DATE: 01/15/13 |
| DATE | BY |
| REVISION | DESCRIPTION |
| NO. | |
| DRAWING TITLE: 8 13/16" DEEP 1630-SS-IR DRY GLAZED SMI CURTAIN WALL | |
| MANUFACTURER: KAWNEER COMPANY, INC. 555 GUTHRIE COURT NORCROSS, GA 30092 770-449-5555 | |
| CONSULTANTS: W. W. SCHAEFER ENGINEERING & CONSULTING, P.A. (CA 6809) 7480 150TH COURT NORTH PALM BEACH GARDENS, FL 33418 PHONE: 561-744-3424 | |
| CERTIFICATION APR 02 2013 | WARREN W. SCHAEFER, P.E. P.E. NO. 44135 |
| DRAWING NO. 1848 | REV. |
| SHEET NO. 9 | OF 21 |

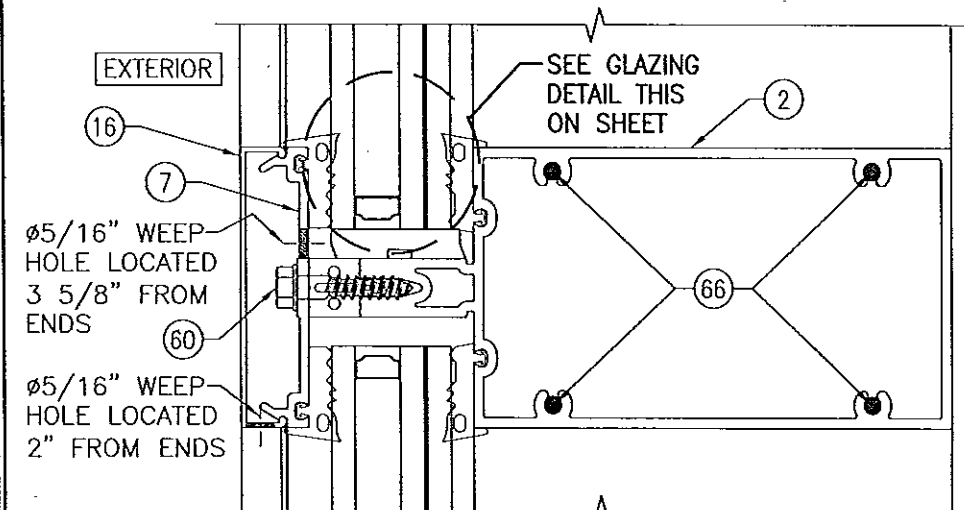


SECTION C1
SCALE: 1/2 FULL

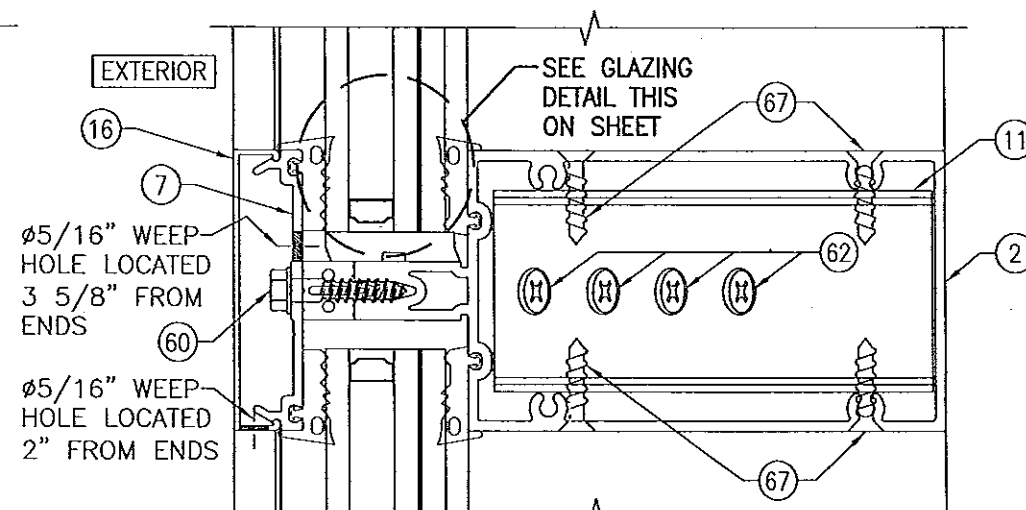

SECTION C2
SCALE: 1/2 FULL

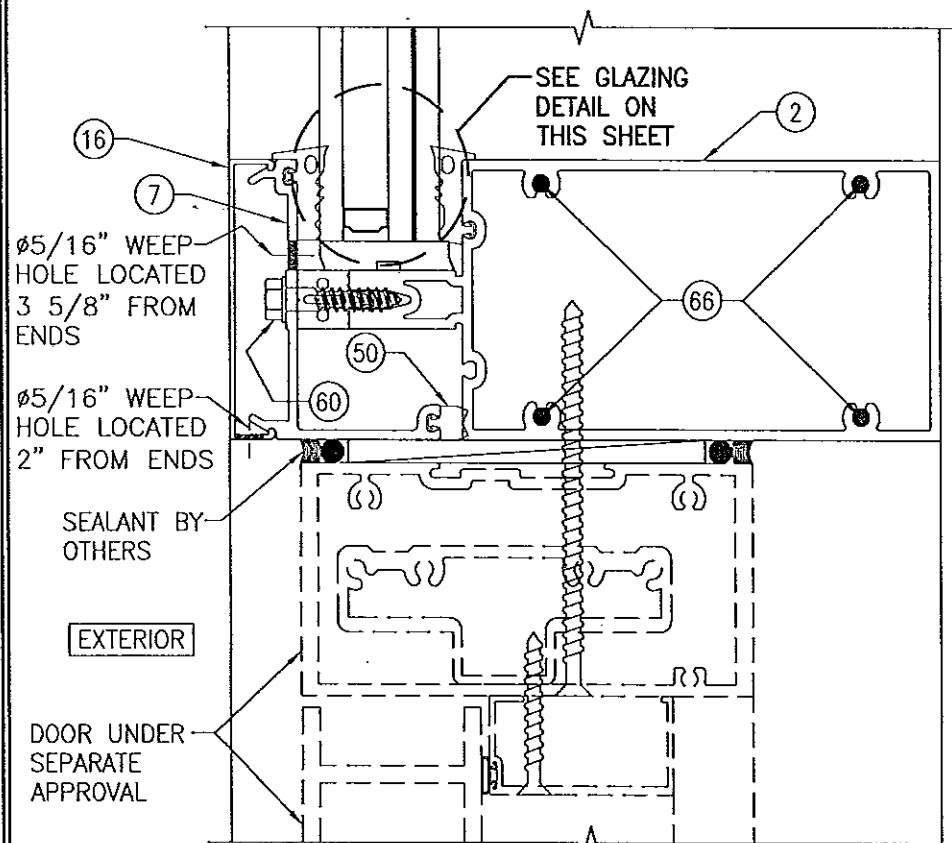


SECTION D
SCALE: 1/2 FULL

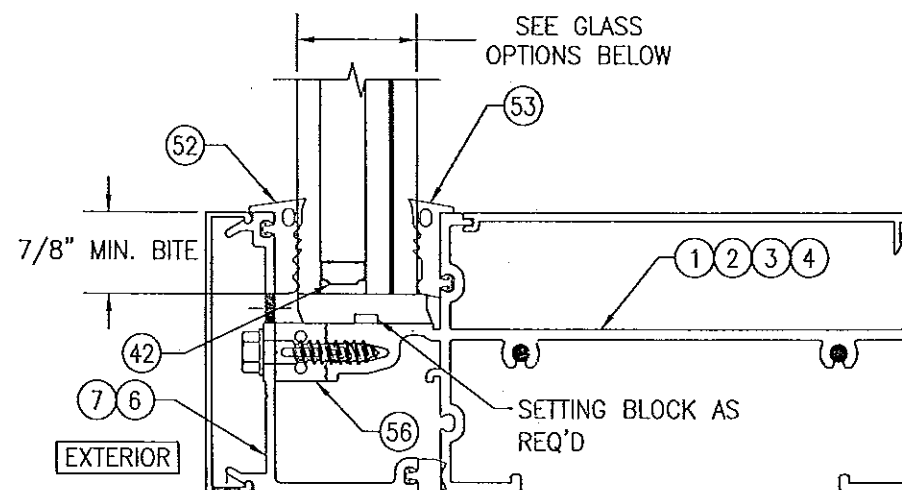

TYPICAL GLAZING DETAIL: GLASS TO STANDARD MEMBERS

GLASS OPTIONS:
 OPTION 1: 1 5/16" THICK I.G LAMINATED GLASS (1/4" TEMP. EXTERIOR; 1/2" AIR SPACE; 1/4" HT. ST./0.060" EASTMAN CHEMICAL CO. SAFLEX/1/4" HT. ST. INTERIOR)
 OPTION 2: 1 5/16" THICK I.G LAMINATED GLASS (1/4" TEMP. EXTERIOR; 1/2" AIR SPACE; 1/4" HT. ST./0.060" DUPONT PVB/1/4" HT. ST. INTERIOR)

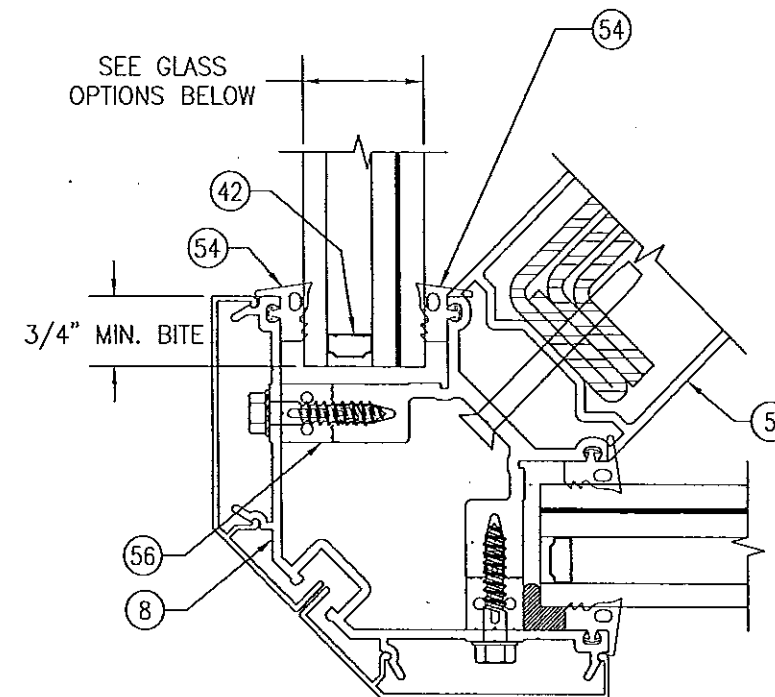


TYPICAL GLAZING DETAIL: GLASS TO CORNER MEMBER




GLASS OPTIONS:
 OPTION 1: 1 5/16" THICK I.G LAMINATED GLASS (1/4" TEMP. EXTERIOR; 1/2" AIR SPACE; 1/4" HT. ST./0.060" EASTMAN CHEMICAL CO. SAFLEX/1/4" HT. ST. INTERIOR)
 OPTION 2: 1 5/16" THICK I.G LAMINATED GLASS (1/4" TEMP. EXTERIOR; 1/2" AIR SPACE; 1/4" HT. ST./0.060" DUPONT PVB/1/4" HT. ST. INTERIOR)

PRODUCT REVISED
 as complying with the Florida Building Code
 Acceptance No. 14-0430.34
 Expiration Date 08/08/2018
 By *[Signature]*
 Miami Dade Product Control

Approved as complying with the Florida Building Code
 Date 08/08/2013
 NOA# 13-0522.13
 Miami Dade Product Control
 By *[Signature]*

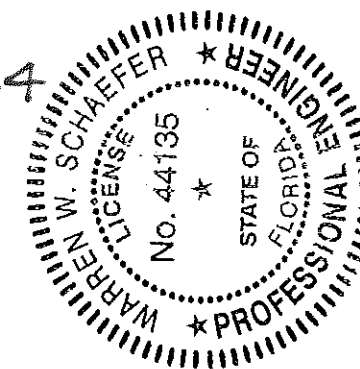

| | | | | |
|---------------|--|-------------|--|--|
| DRAWING TITLE | DRAWN BY: W.R.M. | | CHECKED BY: W.W.S. | |
| | PLOT: 1=2 | | DATE: 01/15/13 | |
| CONSULTANTS | NO. | REVISION | DESCRIPTION | DATE |
| | | | | |
| DRAWING NO. | 8 13/16" DEEP 1630-SS-IR DRY GLAZED SMI CURTAIN WALL | | MANUFACTURER | |
| | 1848 | | KAWNEER COMPANY, INC. 555 GUTHRIE COURT NORCROSS, GA 30092 770-449-5555 | |
| SHEET NO. | 10 OF 21 | | CONSULTANTS | |
| | | | W. W. SCHAEFER ENGINEERING & CONSULTING, P.A. (CA 6809) 7480 150TH COURT NORTH PALM BEACH GARDENS, FL 33418 PHONE: 561-744-3424 | |
| CERTIFICATION | | APR 02 2013 | | WARREN W. SCHAEFER, P.E. P.E. NO. 44135 |

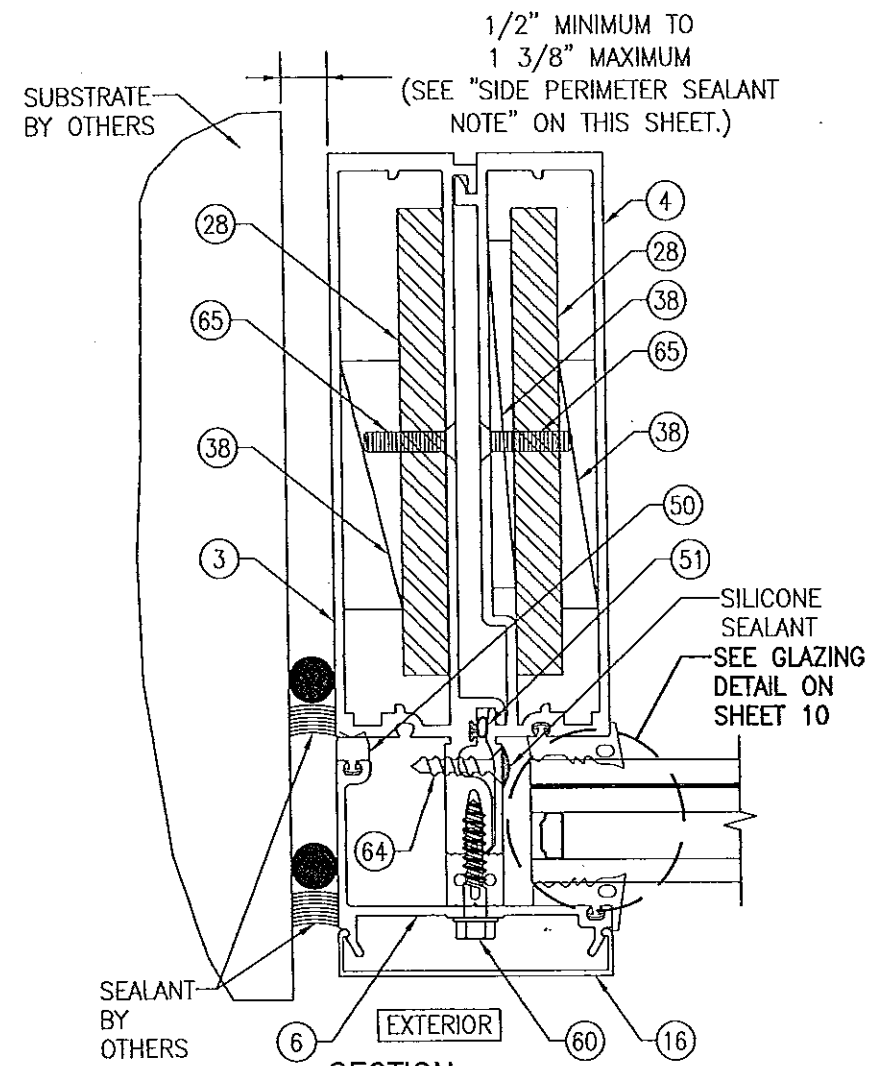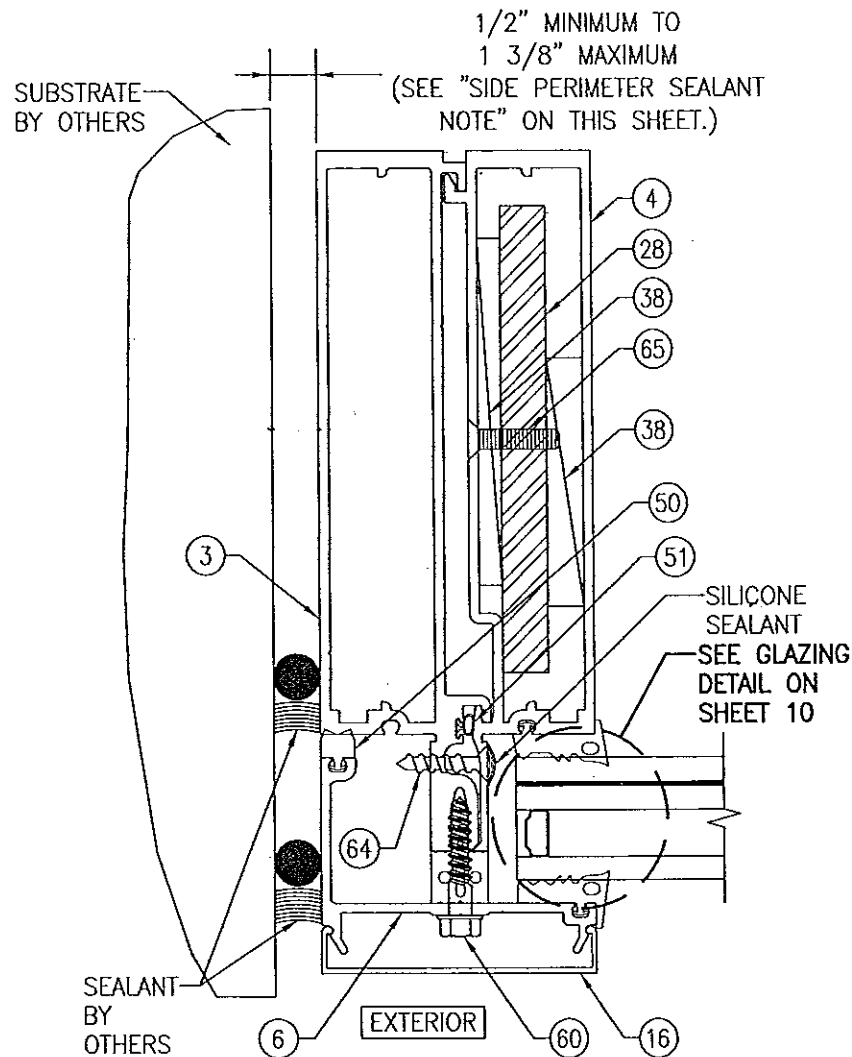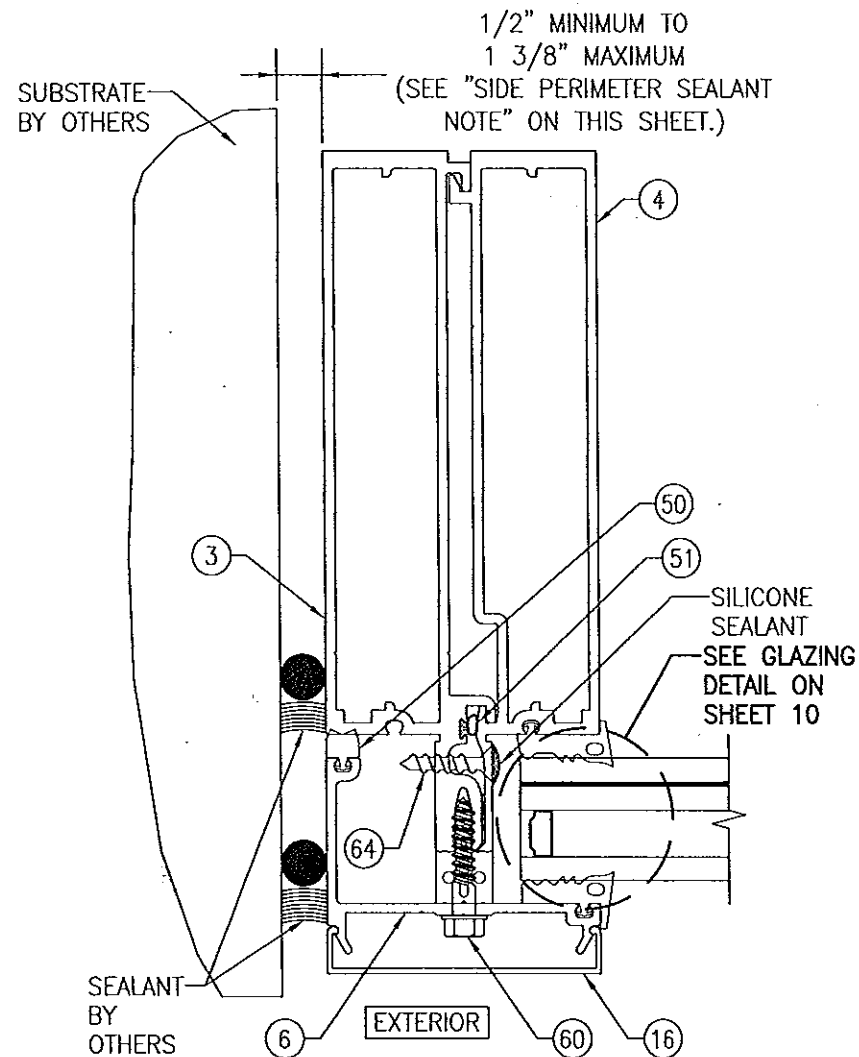


SIDE PERIMETER SEALANT NOTE:


THE MINIMUM & MAXIMUM ALLOWABLE SPACE BETWEEN SIDE FRAME MEMBERS & THE OPENING SUBSTRATE OR FINISHES SHALL BE SPECIFIED BY THE ENGINEER OR ARCHITECT OF RECORD FOR EACH JOB BUT SHALL NOT BE LESS THAN 1/2" NOR GREATER THAN 1 3/8". WHEN CONSIDERING TYPE, DEPTH & JOINT SPAN OF SEALANT, THE ENGINEER/ARCHITECT SHALL TAKE INTO CONSIDERATION THE DEFLECTION OF THE JAMB MEMBER THAT WOULD OCCUR WHILE SUPPORTING THE JOB REQUIRED DESIGN WIND PRESSURE. ALSO TO BE CONSIDERED SHALL BE THE MATERIALS & SURFACES TO WHICH THE SEALANT WILL BE APPLIED.

PRODUCT REVISED
as complying with the Florida
Building Code
Acceptance No. 14-0430.34
Expiration Date 08/08/2018
By *Warren W. Schaefer*
Miami Dade Product Control


Approved as complying with the
Florida Building Code
Date 08/08/2013
NOA# 13-0522.13
Miami Dade Product Control
By *Warren W. Schaefer*

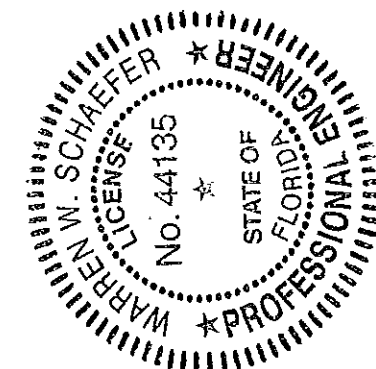


| | | | |
|---|------------------|---|-------------|
| DRAWING BY: W.R.M. | | CHECKED BY: W.W.S. | |
| PLOT: 1=2 | | DATE: 01/15/13 | |
| DATE | BY | REVISION | DESCRIPTION |
| | | | |
| DRAWING TITLE: 8 13/16" DEEP 1630-SS-IR DRY GLAZED SMI CURTAIN WALL | | | |
| CONSULTANTS: W. W. SCHAEFER ENGINEERING & CONSULTING, P.A. (CA 6809) | | MANUFACTURER: KAWNEER COMPANY, INC. | |
| 7480 150TH COURT NORTH PALM BEACH GARDENS, FL 33418 PHONE: 561-744-3424 | | 555 GUTHRIE COURT NORCROSS, GA 30092 770-449-5555 | |
| CERTIFICATION: APR 02 2013 | DRAWING NO. 1848 | | |
| SHEET NO. 11 | | OF 21 | |

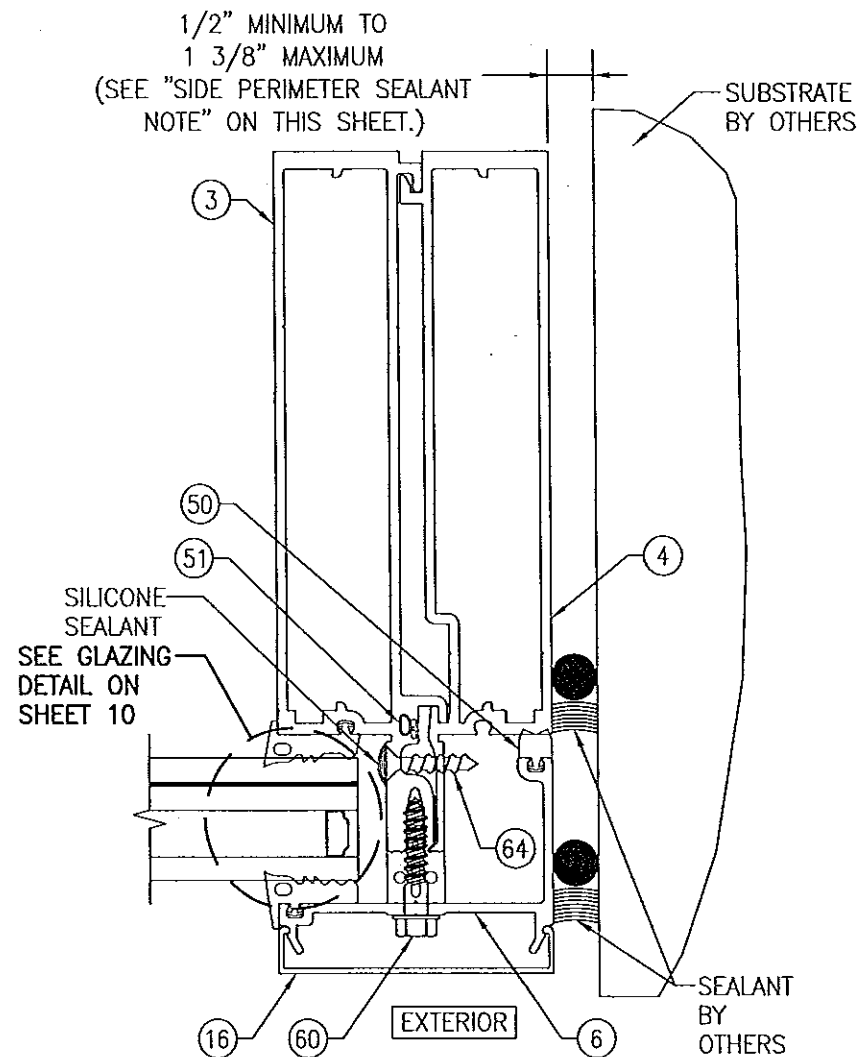

SECTION E4
SCALE: 1/2 FULL 12
SIDE VERTICAL MEMBER WITH
REINFORCEMENT "RO" (NO
REINFORCEMENT)
 $I = 35.410 \text{ IN}^4$
 $S = 8.423 \text{ IN}^3$

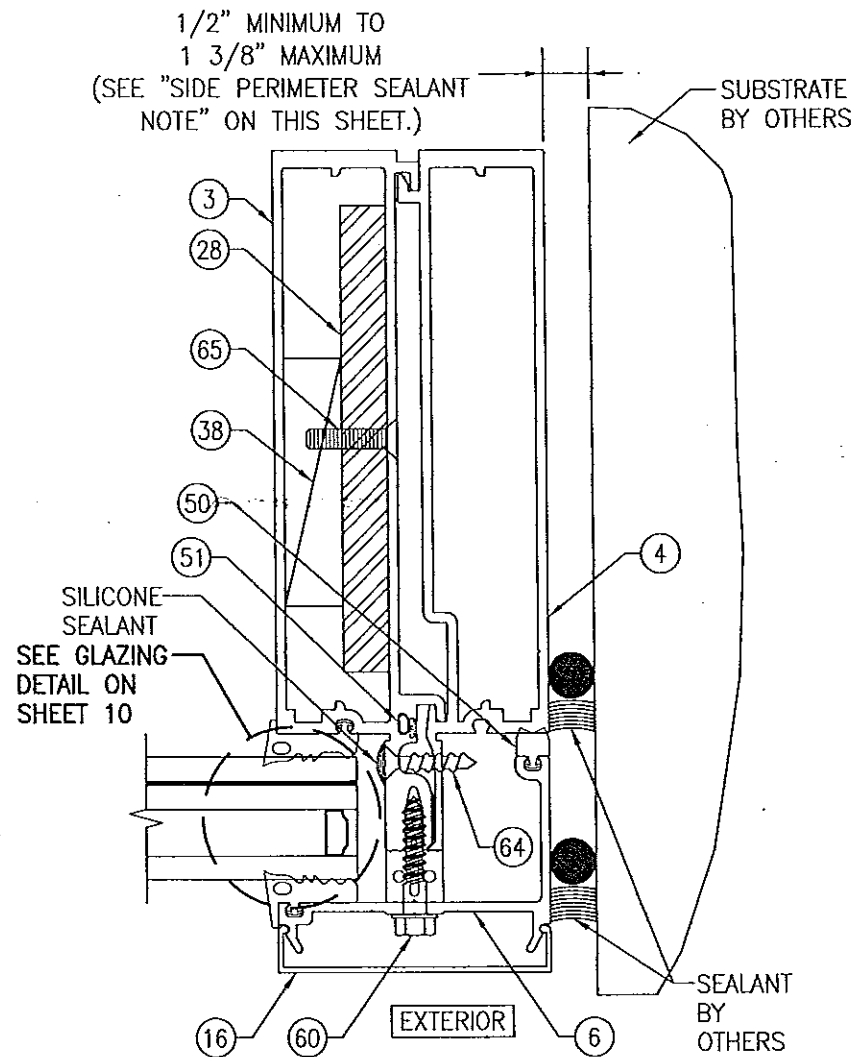

SECTION E5
SCALE: 1/2 FULL 12
SIDE VERTICAL MEMBER WITH
REINFORCEMENT "R1"
 $I = 53.631 \text{ IN}^4$
 $S = 11.128 \text{ IN}^3$
(TRANSFORMED SECTION PROPERTIES IN
TERMS OF ALUMINUM)
(REINFORCEMENT MAY BE AT EITHER HALF OF
VERTICAL MEMBER)

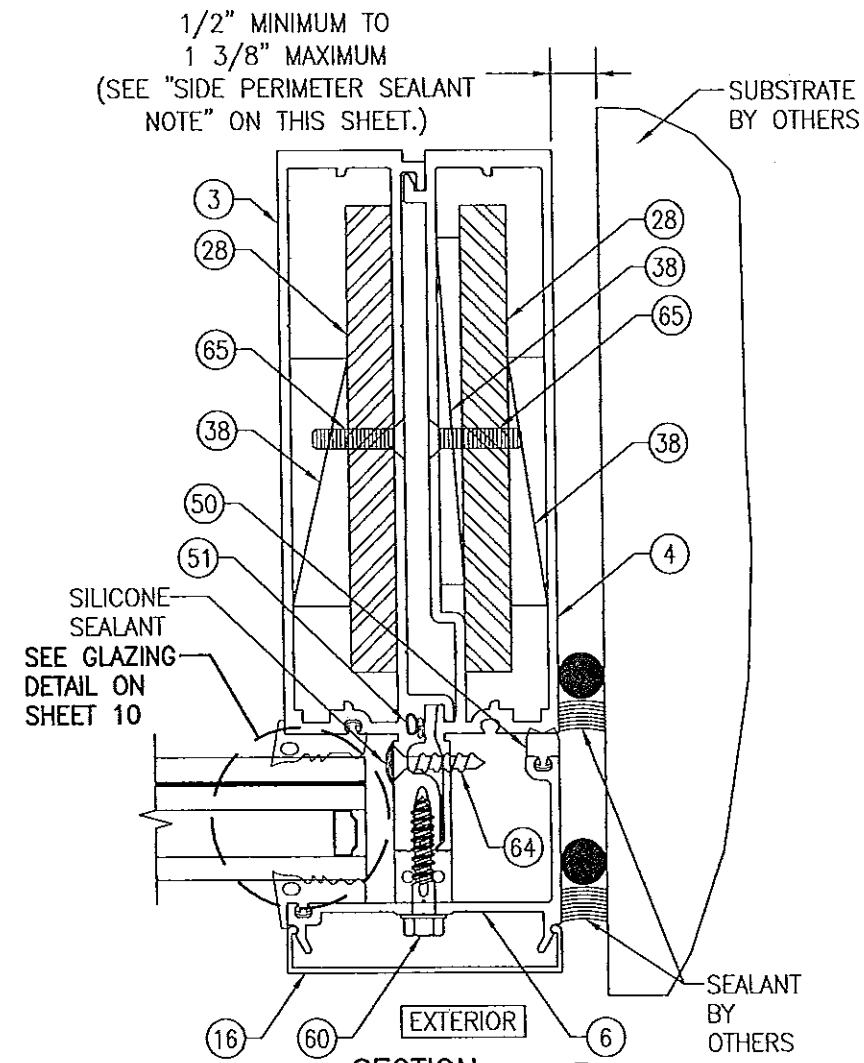


SECTION E6
SCALE: 1/2 FULL 12
SIDE VERTICAL MEMBER WITH
REINFORCEMENT "R2"
 $I = 64.014 \text{ IN}^4$
 $S = 12.960 \text{ IN}^3$
(TRANSFORMED SECTION PROPERTIES IN
TERMS OF ALUMINUM)

SIDE PERIMETER SEALANT NOTE:


THE MINIMUM & MAXIMUM ALLOWABLE SPACE BETWEEN SIDE FRAME MEMBERS & THE OPENING SUBSTRATE OR FINISHES SHALL BE SPECIFIED BY THE ENGINEER OR ARCHITECT OF RECORD FOR EACH JOB BUT SHALL NOT BE LESS THAN 1/2" NOR GREATER THAN 1 3/8". WHEN CONSIDERING TYPE, DEPTH & JOINT SPAN OF SEALANT, THE ENGINEER/ARCHITECT SHALL TAKE INTO CONSIDERATION THE DEFLECTION OF THE JAMB MEMBER THAT WOULD OCCUR WHILE SUPPORTING THE JOB REQUIRED DESIGN WIND PRESSURE. ALSO TO BE CONSIDERED SHALL BE THE MATERIALS & SURFACES TO WHICH THE SEALANT WILL BE APPLIED.

PRODUCT REVISED
as complying with the Florida
Building Code
Acceptance No. 14-0430.34
Expiration Date 08/08/2018
By *[Signature]*
Miami Dade Product Control

Approved as complying with the
Florida Building Code
Date 08/08/2013
NOA# 13-0522.13
Miami Dade Product Control
By *[Signature]*

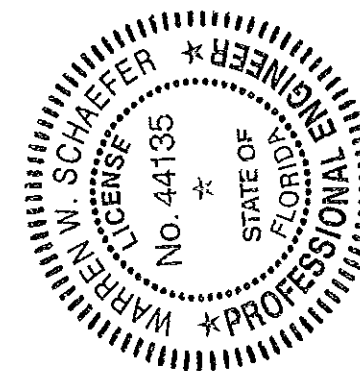


| | | | |
|---|----------|--|------|
| DRAWN BY: W.R.M. | | CHECKED BY: W.R.S. | |
| PLOT: 1=2 | | DATE: 01/15/13 | |
| NO. | REVISION | DESCRIPTION | DATE |
| 1 | | | |
| 2 | | | |
| 3 | | | |
| 4 | | | |
| 5 | | | |
| 6 | | | |
| 7 | | | |
| 8 | | | |
| 9 | | | |
| 10 | | | |
| 11 | | | |
| 12 | | | |
| DRAWING TITLE: 8 13/16" DEEP 1630-SS-IR DRY GLAZED SMI CURTAIN WALL | | | |
| CONSULTANTS W. W. SCHAEFER ENGINEERING & CONSULTING, P.A. (CA 6809) | | MANUFACTURER KAWNEER COMPANY, INC. 555 GUTHRIE COURT NORCROSS, GA 30092 770-449-5555 | |
| 7480 150TH COURT NORTH PALM BEACH GARDENS, FL 33418 PHONE: 561-744-3424 | | P.E. NO. 44135 WARREN W. SCHAEFER, P.E. | |
| CERTIFICATION APR 02 2013 | | DRAWING NO. 1848 | |
| SHEET NO. 12 | | OF 21 | |

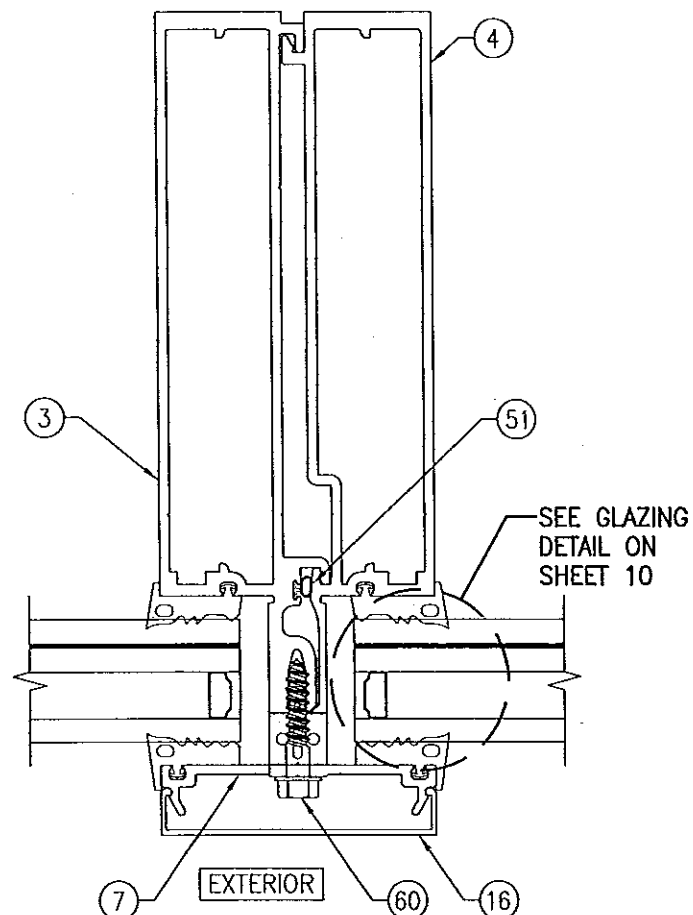


SECTION F1
SCALE: 1/2 FULL
INTERMEDIATE VERTICAL MEMBER
WITH REINFORCEMENT "R0" (NO
REINFORCEMENT)

$I = 33.770 \text{ IN}^4$
 $S = 7.820 \text{ IN}^3$

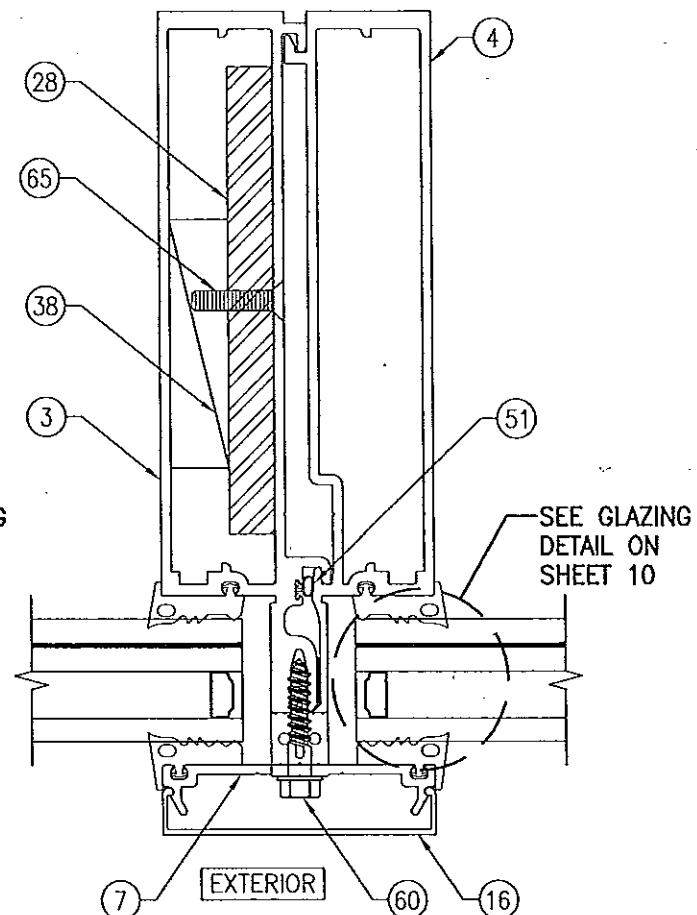


SECTION F2
SCALE: 1/2 FULL
INTERMEDIATE VERTICAL MEMBER
WITH REINFORCEMENT "R1"

$I = 51.258 \text{ IN}^4$
 $S = 10.513 \text{ IN}^3$
(TRANSFORMED SECTION PROPERTIES IN
TERMS OF ALUMINUM)
(REINFORCEMENT MAY BE PLACED AT EITHER
INTERMEDIATE FRAME MEMBER HALF)

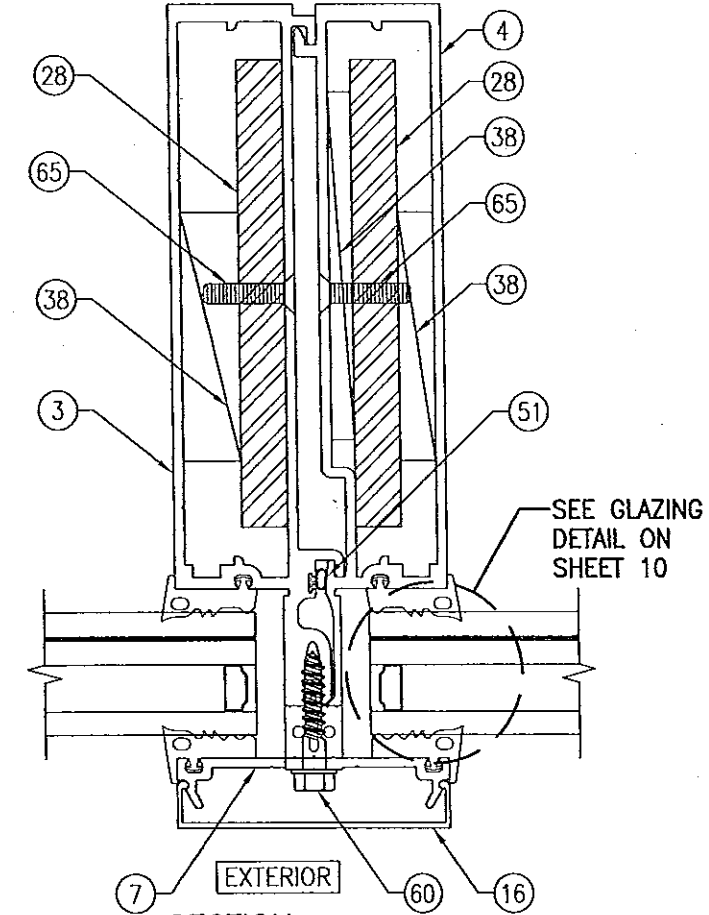

SECTION F3
SCALE: 1/2 FULL
INTERMEDIATE VERTICAL MEMBER
WITH REINFORCEMENT "R2"

$I = 61.484 \text{ IN}^4$
 $S = 12.343 \text{ IN}^3$
(TRANSFORMED SECTION PROPERTIES IN
TERMS OF ALUMINUM)

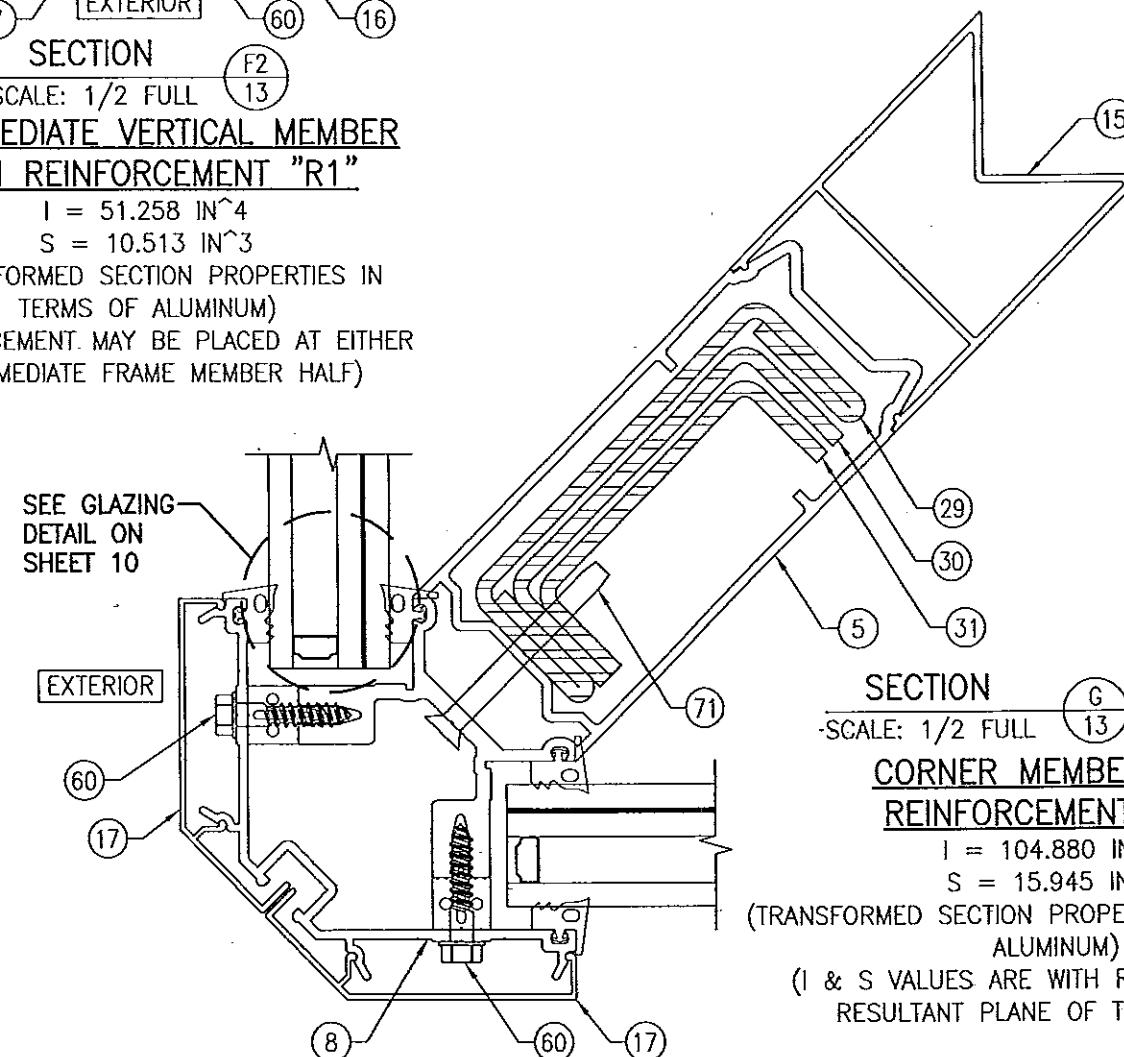


SECTION G
SCALE: 1/2 FULL
CORNER MEMBER WITH
REINFORCEMENT "R3"

$I = 104.880 \text{ IN}^4$
 $S = 15.945 \text{ IN}^3$
(TRANSFORMED SECTION PROPERTIES IN TERMS OF
ALUMINUM)
(I & S VALUES ARE WITH RESPECT TO THE
RESULTANT PLANE OF THE MEMBER)

PRODUCT REVISED
as complying with the Florida
Building Code
Acceptance No. 14-0430.34
Expiration Date 08/08/2018
By *Warren W. Schaefer*
Miami Dade Product Control

Approved as complying with the
Florida Building Code
Date 08/08/2013
NOA# 130522.13
Miami Dade Product Control
By *Warren W. Schaefer*

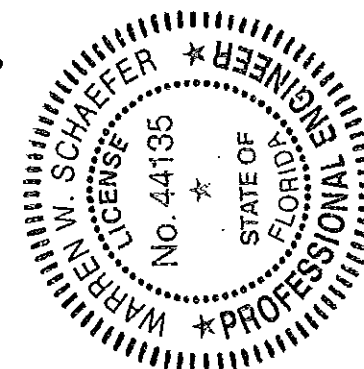

| | | | |
|---|----------|--|------|
| DRAWN BY: W.R.M. | | CHECKED BY: W.W.S. | |
| PLOT: 1=2 | | DATE: 01/15/13 | |
| NO. | REVISION | DESCRIPTION | DATE |
| | | | |
| | | | |
| | | | |
| | | | |
| DRAWING TITLE: 8 13/16" DEEP 1630-SS-IR DRY GLAZED SMI CURTAIN WALL | | | |
| CONSULTANTS W. W. SCHAEFER ENGINEERING & CONSULTING, P.A. (CA 6809) | | MANUFACTURER KAWNEER COMPANY, INC. 555 GUTHRIE COURT NORCROSS, GA 30092 770-449-5555 | |
| 7480 150TH COURT NORTH PALM BEACH GARDENS, FL 33418 PHONE: 561-744-3424 | | CERTIFICATION APR 02 2013 | |
| DRAWING NO. 1848 | | REV. | |
| SHEET NO. 13 | | OF 21 | |

SILICONE BETWEEN
SURFACES OF ANGLES
AND BRAKE METAL

SIDE FRAME MEMBER &
REINFORCEMENT PER
SECTIONS E1/12, E2/12,
E3/12, E4/13, E5/13 OR
E6/13.

SILICONE BETWEEN
SURFACES OF ANGLES
AND BRAKE METAL

SIDE FRAME MEMBER &
REINFORCEMENT PER
SECTIONS E1/12, E2/12,
E3/12, E4/13, E5/13 OR
E6/13.

SILICONE BETWEEN
SURFACES OF ANGLES
AND BRAKE METAL

SEALANT BY
OTHERS

SIDE FRAME MEMBER &
REINFORCEMENT PER
SECTIONS E1/12, E2/12,
E3/12, E4/13, E5/13 OR
E6/13.

SECTION
SCALE: 1/2 FULL

90 DEG. INTERIOR CORNER MEMBER WITH
REINFORCEMENT "R0", "R1" OR "R3"

SECTION
SCALE: 1/2 FULL


135 DEG. INTERIOR CORNER MEMBER WITH
REINFORCEMENT "R0", "R1" OR "R3"

PRODUCT REVISED
as complying with the Florida
Building Code
Acceptance No. 14-0430.34
Expiration Date 08/08/2013
By *Warren W. Schaeffer*
Miami Dade Product Control


Approved as complying with the
Florida Building Code
Date 08/08/2013
NOA# 13-0522.13
Miami Dade Product Control
By *Warren W. Schaeffer*




| | | | |
|---|---------------------|--|-----|
| DRAWN BY: W.R.M. | | CHECKED BY: W.W.S. | |
| PLOT: 1=2 | | DATE: 01/15/13 | |
| DATE | BY | REVISION DESCRIPTION | NO. |
| | | | |
| DRAWING TITLE 8 13/16" DEEP 1630-SS-IR DRY GLAZED SMI CURTAIN WALL | | | |
| CONSULTANTS W. W. SCHAEFFER ENGINEERING & CONSULTING, P.A. (CA 6809) | | MANUFACTURER KAWNEER COMPANY, INC. 555 GUTHRIE COURT NORCROSS, GA 30092 770-449-5555 | |
| 7480 150TH COURT NORTH PALM BEACH GARDENS, FL 33418 PHONE: 561-744-3424 | | P.E. WARREN W. SCHAEFFER P.E. NO. 44135 | |
| CERTIFICATION APR 08 2013 | DRAWING NO. 1848 | REV. SHEET NO. 14 OF 21 | |

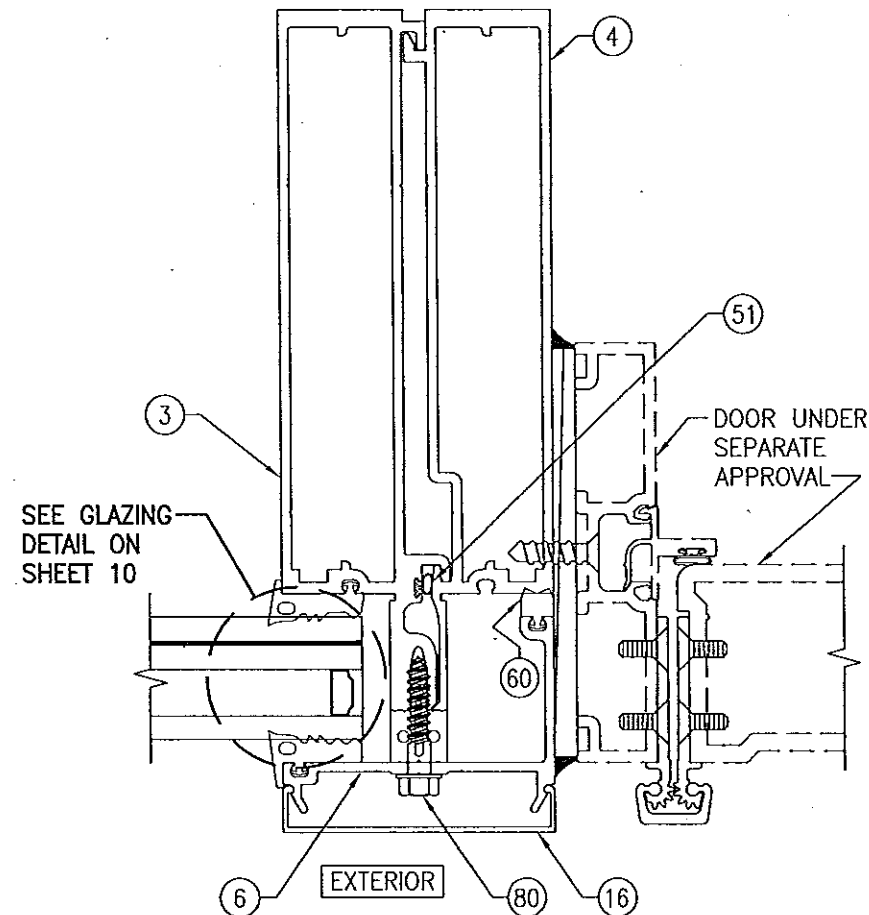

SECTION H1
SCALE: 1/2 FULL
INTERMEDIATE VERTICAL MEMBER
WITH DOOR & REINFORCEMENT "R0"
(NO REINFORCEMENT)
 $I = 33.770 \text{ IN}^4$
 $S = 7.820 \text{ IN}^3$

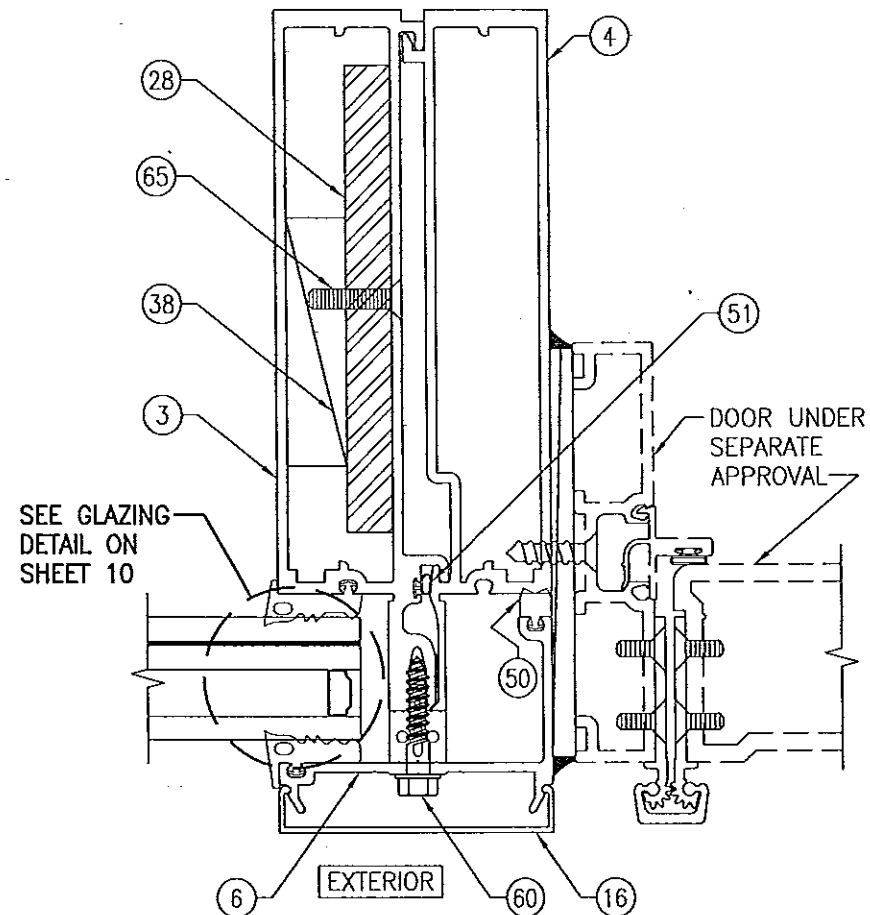


SECTION H2
SCALE: 1/2 FULL
INTERMEDIATE VERTICAL MEMBER
WITH DOOR & REINFORCEMENT "R1"
 $I = 51.258 \text{ IN}^4$
 $S = 10.513 \text{ IN}^3$
(TRANSFORMED SECTION PROPERTIES IN TERMS
OF ALUMINUM)
(REINFORCEMENT MAY BE PLACED AT EITHER
INTERMEDIATE FRAME MEMBER HALF)

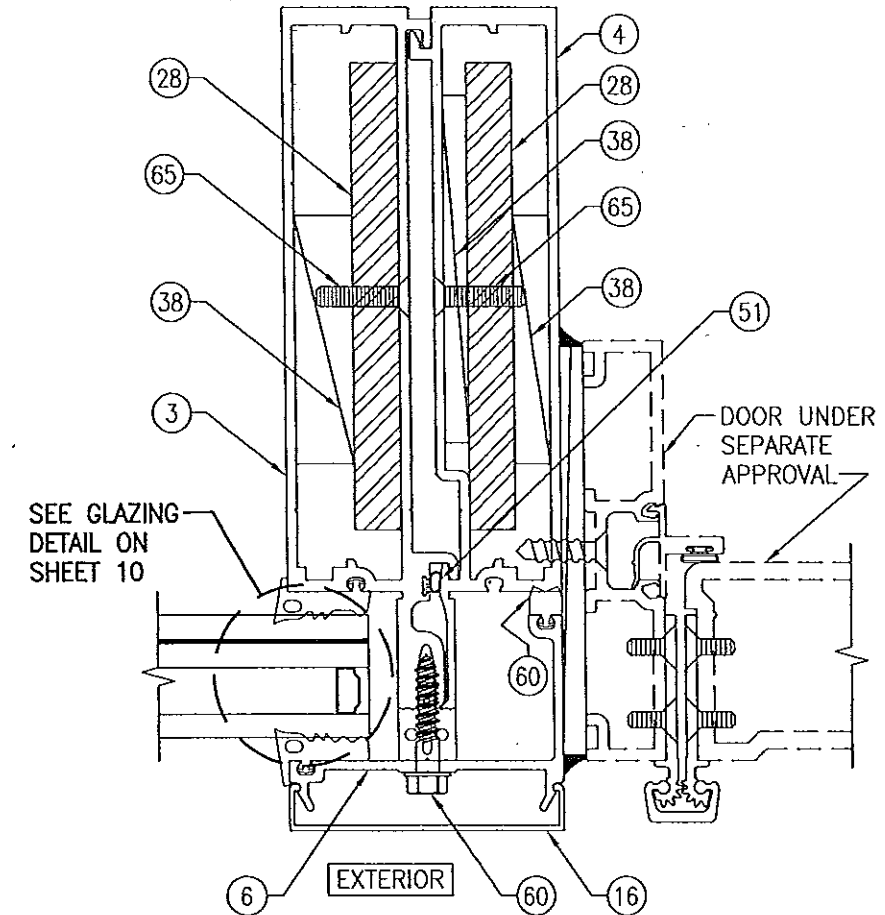


SECTION H3
SCALE: 1/2 FULL
INTERMEDIATE VERTICAL MEMBER WITH
DOOR & REINFORCEMENT "R2"
 $I = 61.484 \text{ IN}^4$
 $S = 12.343 \text{ IN}^3$
(TRANSFORMED SECTION PROPERTIES IN TERMS
OF ALUMINUM)

PRODUCT REVISED
as complying with the Florida
Building Code
Acceptance No. 14-0430.34
Expiration Date 08/08/2013
By *[Signature]*
Miami Dade Product Control


Approved as complying with the
Florida Building Code
Date 08/08/2013
NOA# 13-0522.13
Miami Dade Product Control
By *[Signature]*

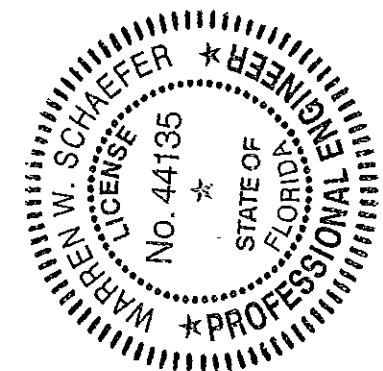

| | | | |
|--|----|--|-------------|
| DRAWN BY: W.R.M. | | CHECKED BY: W.W.S. | |
| PLOT: 1=2 | | DATE: 01/15/13 | |
| DATE | BY | REVISION | DESCRIPTION |
| | | | |
| | | | |
| | | | |
| | | | |
| DRAWING TITLE 8 13/16" DEEP 1630-SS-IR DRY GLAZED SMI CURTAIN WALL | | | |
| CONSULTANTS W. W. SCHAEFER ENGINEERING & CONSULTING, P.A. (CA 6809) 7480 150TH COURT NORTH PALM BEACH GARDENS, FL 33418 PHONE: 561-744-3424 | | MANUFACTURER KAWNEER COMPANY, INC. 555 GUTHRIE COURT NORCROSS, GA 30092 770-449-5555 | |
| CERTIFICATION APR 02 2013 | | DRAWING NO. 1848 | |
| WARREN W. SCHAEFER, P.E. P.E. NO. 44135 | | SHEET NO. 15 OF 21 | |

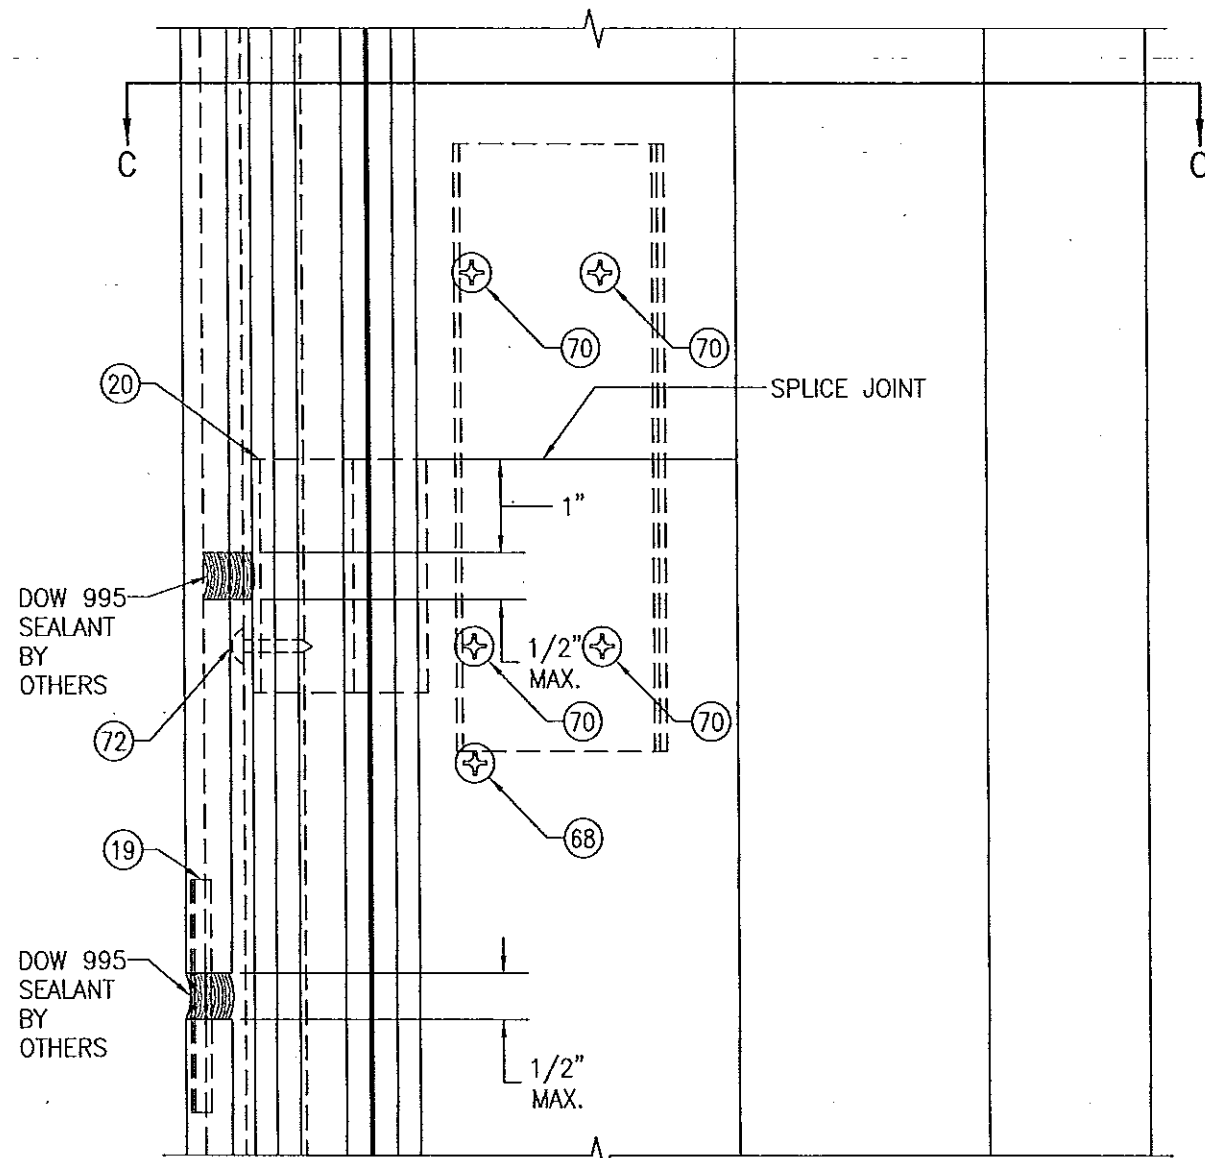


SPlice JOINT DETAIL
(CORNER MEMBER)

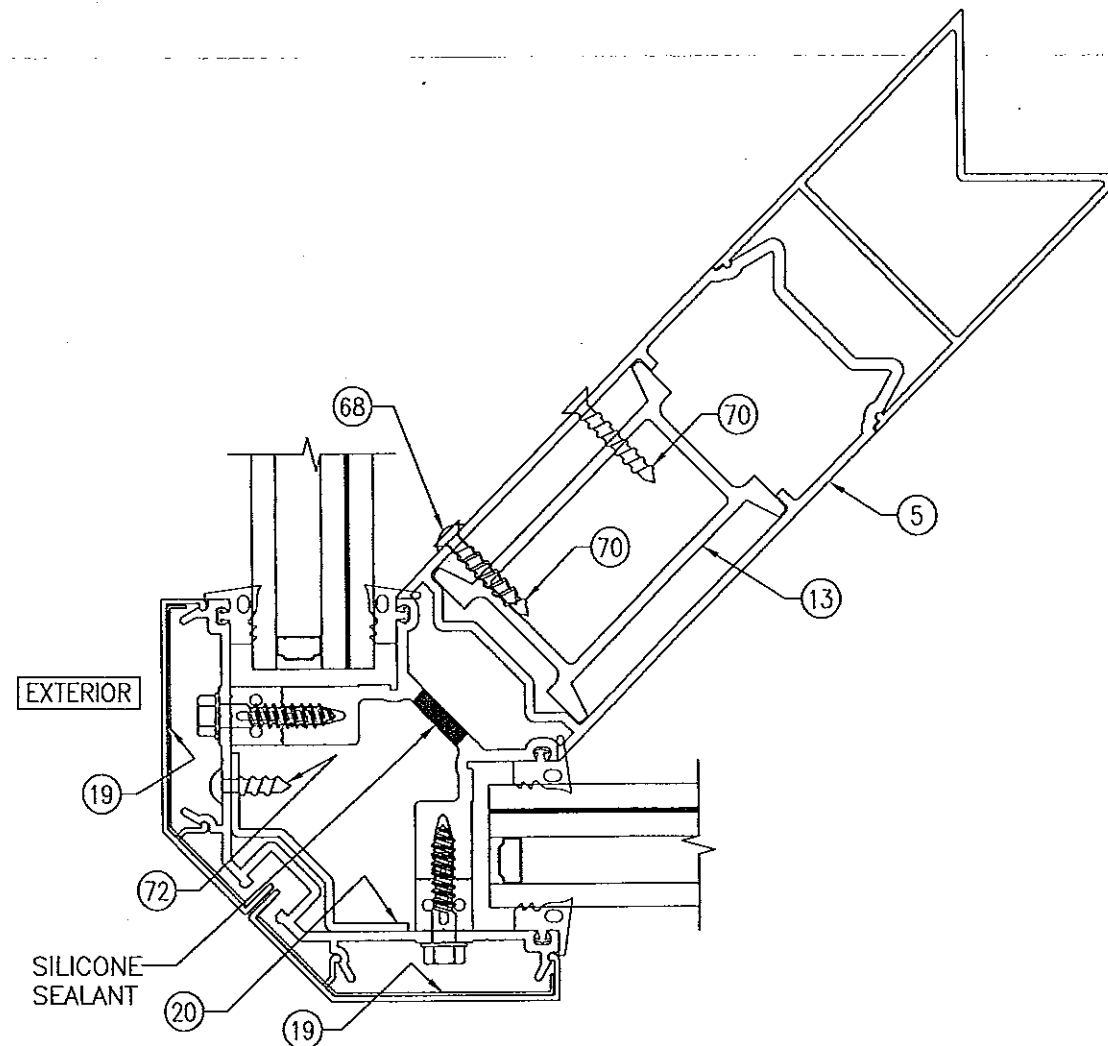


SECTION C-C
(FOR DETAIL NOT SHOWN, SEE SECTION G1/13)

PRODUCT REVISED
as complying with the Florida
Building Code
Acceptance No. 14-0430.34
Expiration Date 08/08/2018
By *Warren W. Schaefer*
Miami Dade Product Control


Approved as complying with the
Florida Building Code
Date 08/08/2013
NOA# 13-0522.13
Miami Dade Product Control
By *Warren W. Schaefer*

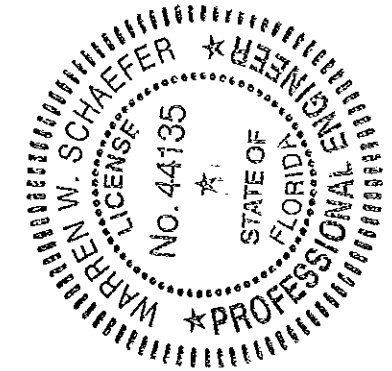


| | | | |
|--|----------|--|------|
| DRAWN BY: W.R.M. | | CHECKED BY: W.W.S. | |
| PLOT: 1-2 | | DATE: 01/15/13 | |
| NO. | REVISION | DESCRIPTION | DATE |
| | | | |
| | | | |
| | | | |
| | | | |
| DRAWING TITLE 8 13/16" DEEP 1630-SS-IR DRY GLAZED SMI CURTAIN WALL | | | |
| CONSULTANTS W. W. SCHAEFER ENGINEERING & CONSULTING, P.A. (CA 6809) 7480 150TH COURT NORTH PALM BEACH GARDENS, FL 33418 PHONE: 561-744-3424 | | MANUFACTURER KAWNEER COMPANY, INC. 555 GUTHRIDGE COURT NORCROSS, GA 30092 770-449-5555 | |
| CERTIFICATION APR 08/2013 WARREN W. SCHAEFER, P.E. P.E. NO. 44135 | | DRAWING NO. 1848 | |
| | | REV. | |
| | | SHEET NO. 17 OF 21 | |

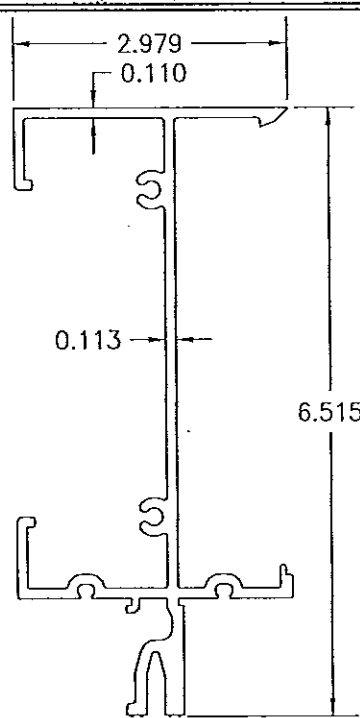


① **HEAD & SILL MEMBER**
 $I = 10.596 \text{ IN}^4$
 $S = 3.172 \text{ IN}^3$

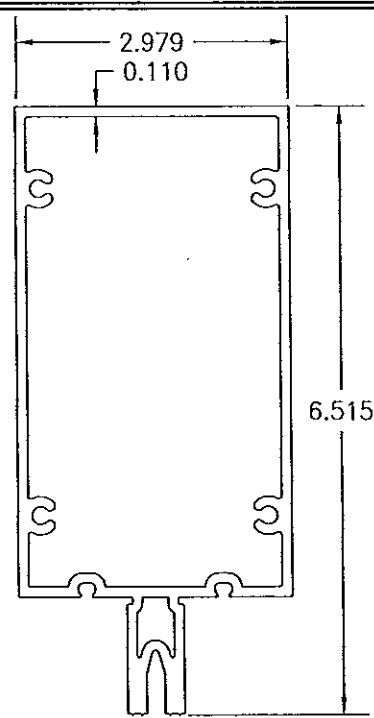


② **INTERMEDIATE HORIZONTAL MEMBER**
 $I = 11.969 \text{ IN}^4$
 $S = 3.668 \text{ IN}^3$

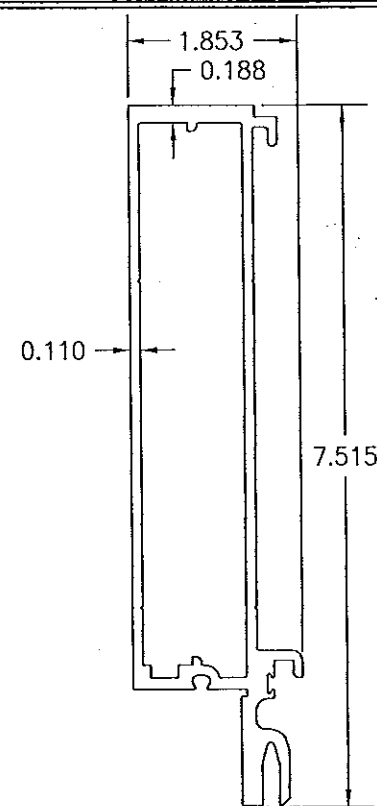


③ **SIDE OR INTERMEDIATE VERTICAL MEMBER (MALE HALF)**
 $I = 14.133 \text{ IN}^4$
 $S = 3.739 \text{ IN}^3$

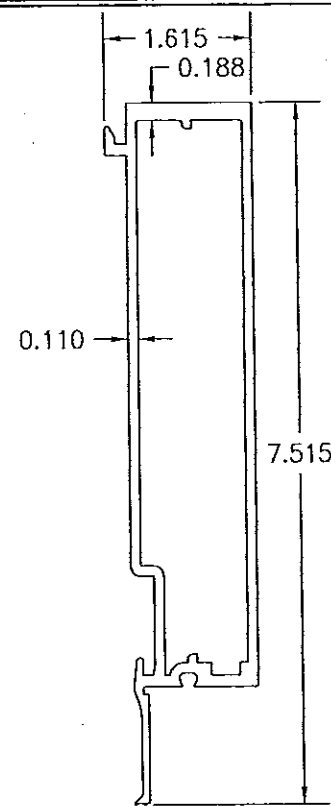


④ **SIDE OR INTERMEDIATE VERTICAL MEMBER (FEMALE HALF)**
 $I = 10.378 \text{ IN}^4$
 $S = 2.441 \text{ IN}^3$

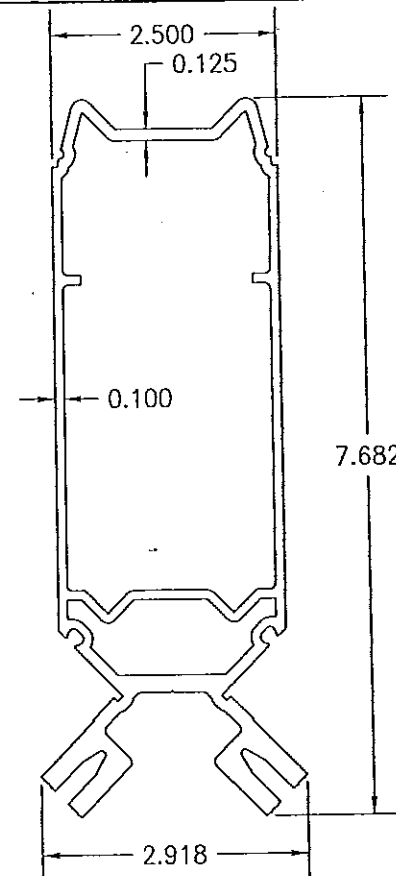

⑤ **CORNER MEMBER**
 $I = 20.024 \text{ IN}^4$
 $S = 4.399 \text{ IN}^3$

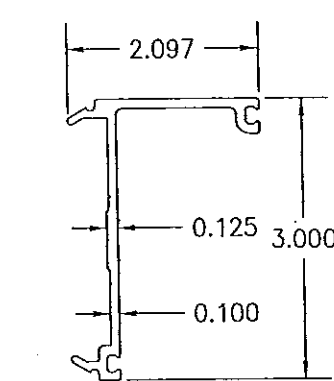


⑥ **PRESSURE PLATE (USED WITH HEAD, SILL OR SIDE MEMBERS)**

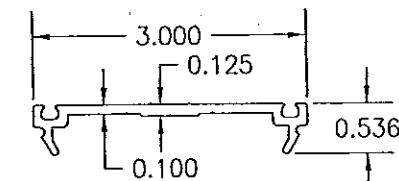


⑦ **PRESSURE PLATE (USED WITH INTERMEDIATE VERTICAL AND INTERMEDIATE HORIZONTAL MEMBERS)**



PRODUCT REVISED
 as complying with the Florida
 Building Code
 Acceptance No. **14-0430.34**
 Expiration Date **08/08/2018**
 By *[Signature]*
 Miami Dade Product Control

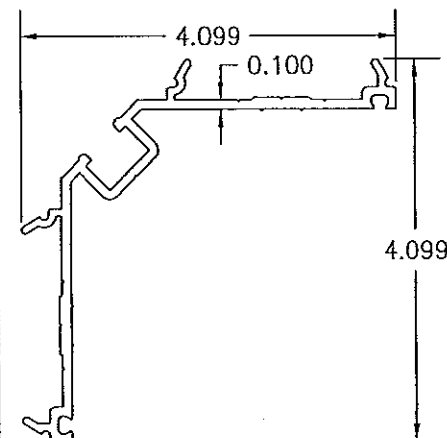



⑧ **PRESSURE PLATE (USED WITH CORNER MEMBER)**

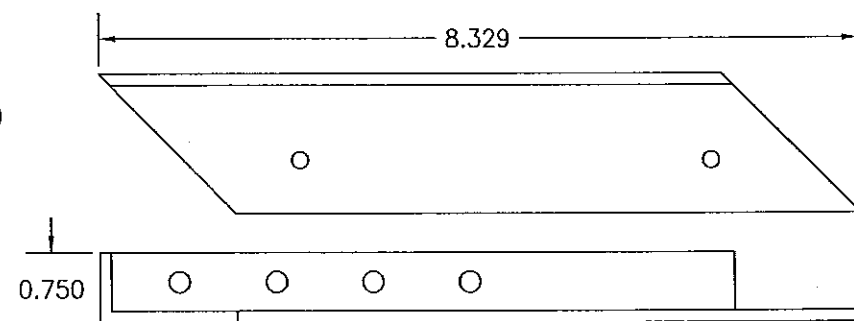


⑨ **SHEAR BLOCK (HEAD TO CORNER MEMBER)**

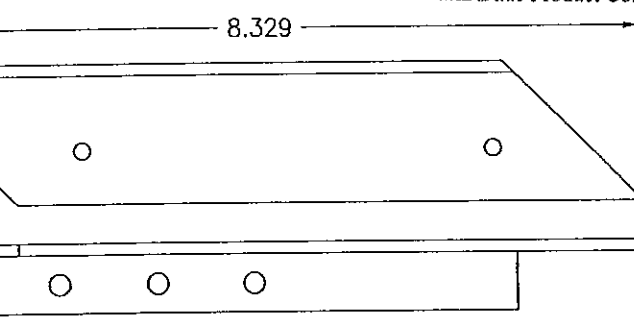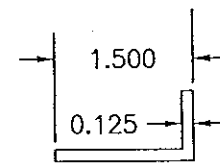


⑩ **SHEAR BLOCK (SILL TO CORNER MEMBER)**

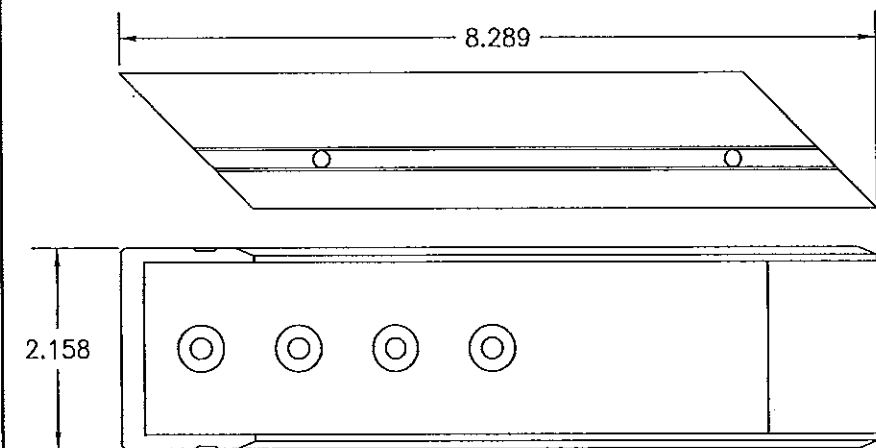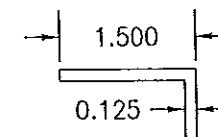

⑪ **SHEAR BLOCK (INTERMEDIATE HORIZONTAL TO CORNER MEMBER)**

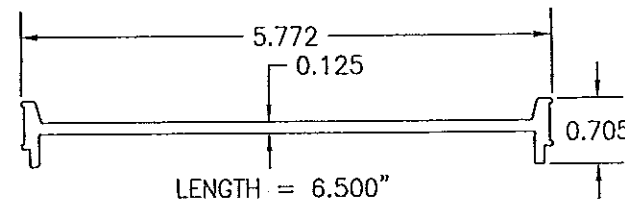


⑫ **SPLICE SLEEVE (USED WITH SIDE & INTERMEDIATE MEMBERS)**

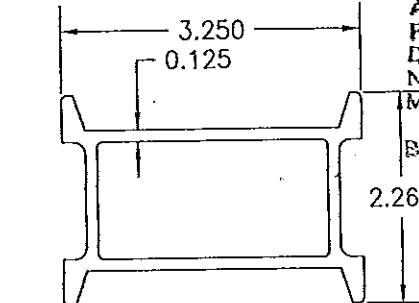

⑬ **SPLICE SLEEVE (USED WITH CORNER MEMBER)**

Approved as complying with the
 Florida Building Code
 Date **03/08/2013**
 NOAH **13-0522.13**
 Miami Dade Product Control
 By *[Signature]*

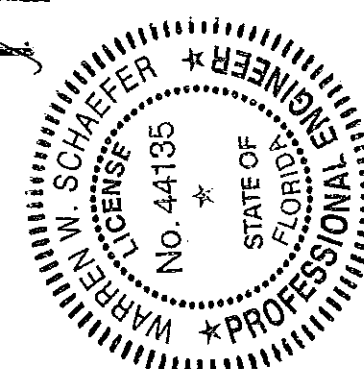

| | |
|---------------------|-----------------------|
| DRAWN BY: W.R.M. | CHECKED BY: W.W.S. |
| PLOT: 1=2 | DATE: 01/15/13 |
| NO. | REVISION DESCRIPTION |
| 1 | DATE |
| 2 | BY |
| 3 | DATE |
| 4 | BY |
DRAWING TITLE: **8 13/16" DEEP 1630-SS-IR DRY GLAZED SMI CURTAIN WALL**


MANUFACTURER: **KAWNEER COMPANY, INC.**

555 GUTHRIE COURT
 NORCROSS, GA 30092
 770-449-5555

CONSULTANTS: **W. W. SCHAEFER ENGINEERING & CONSULTING, P.A. (CA 6809)**


7480 150TH COURT NORTH
 PALM BEACH GARDENS, FL 33418
 PHONE: 561-744-3424

| | |
|------------------------------|--------------|
| CERTIFICATION APR 02 2013 | REV. 1848 |
| SHEET NO. 18 | OF 21 |

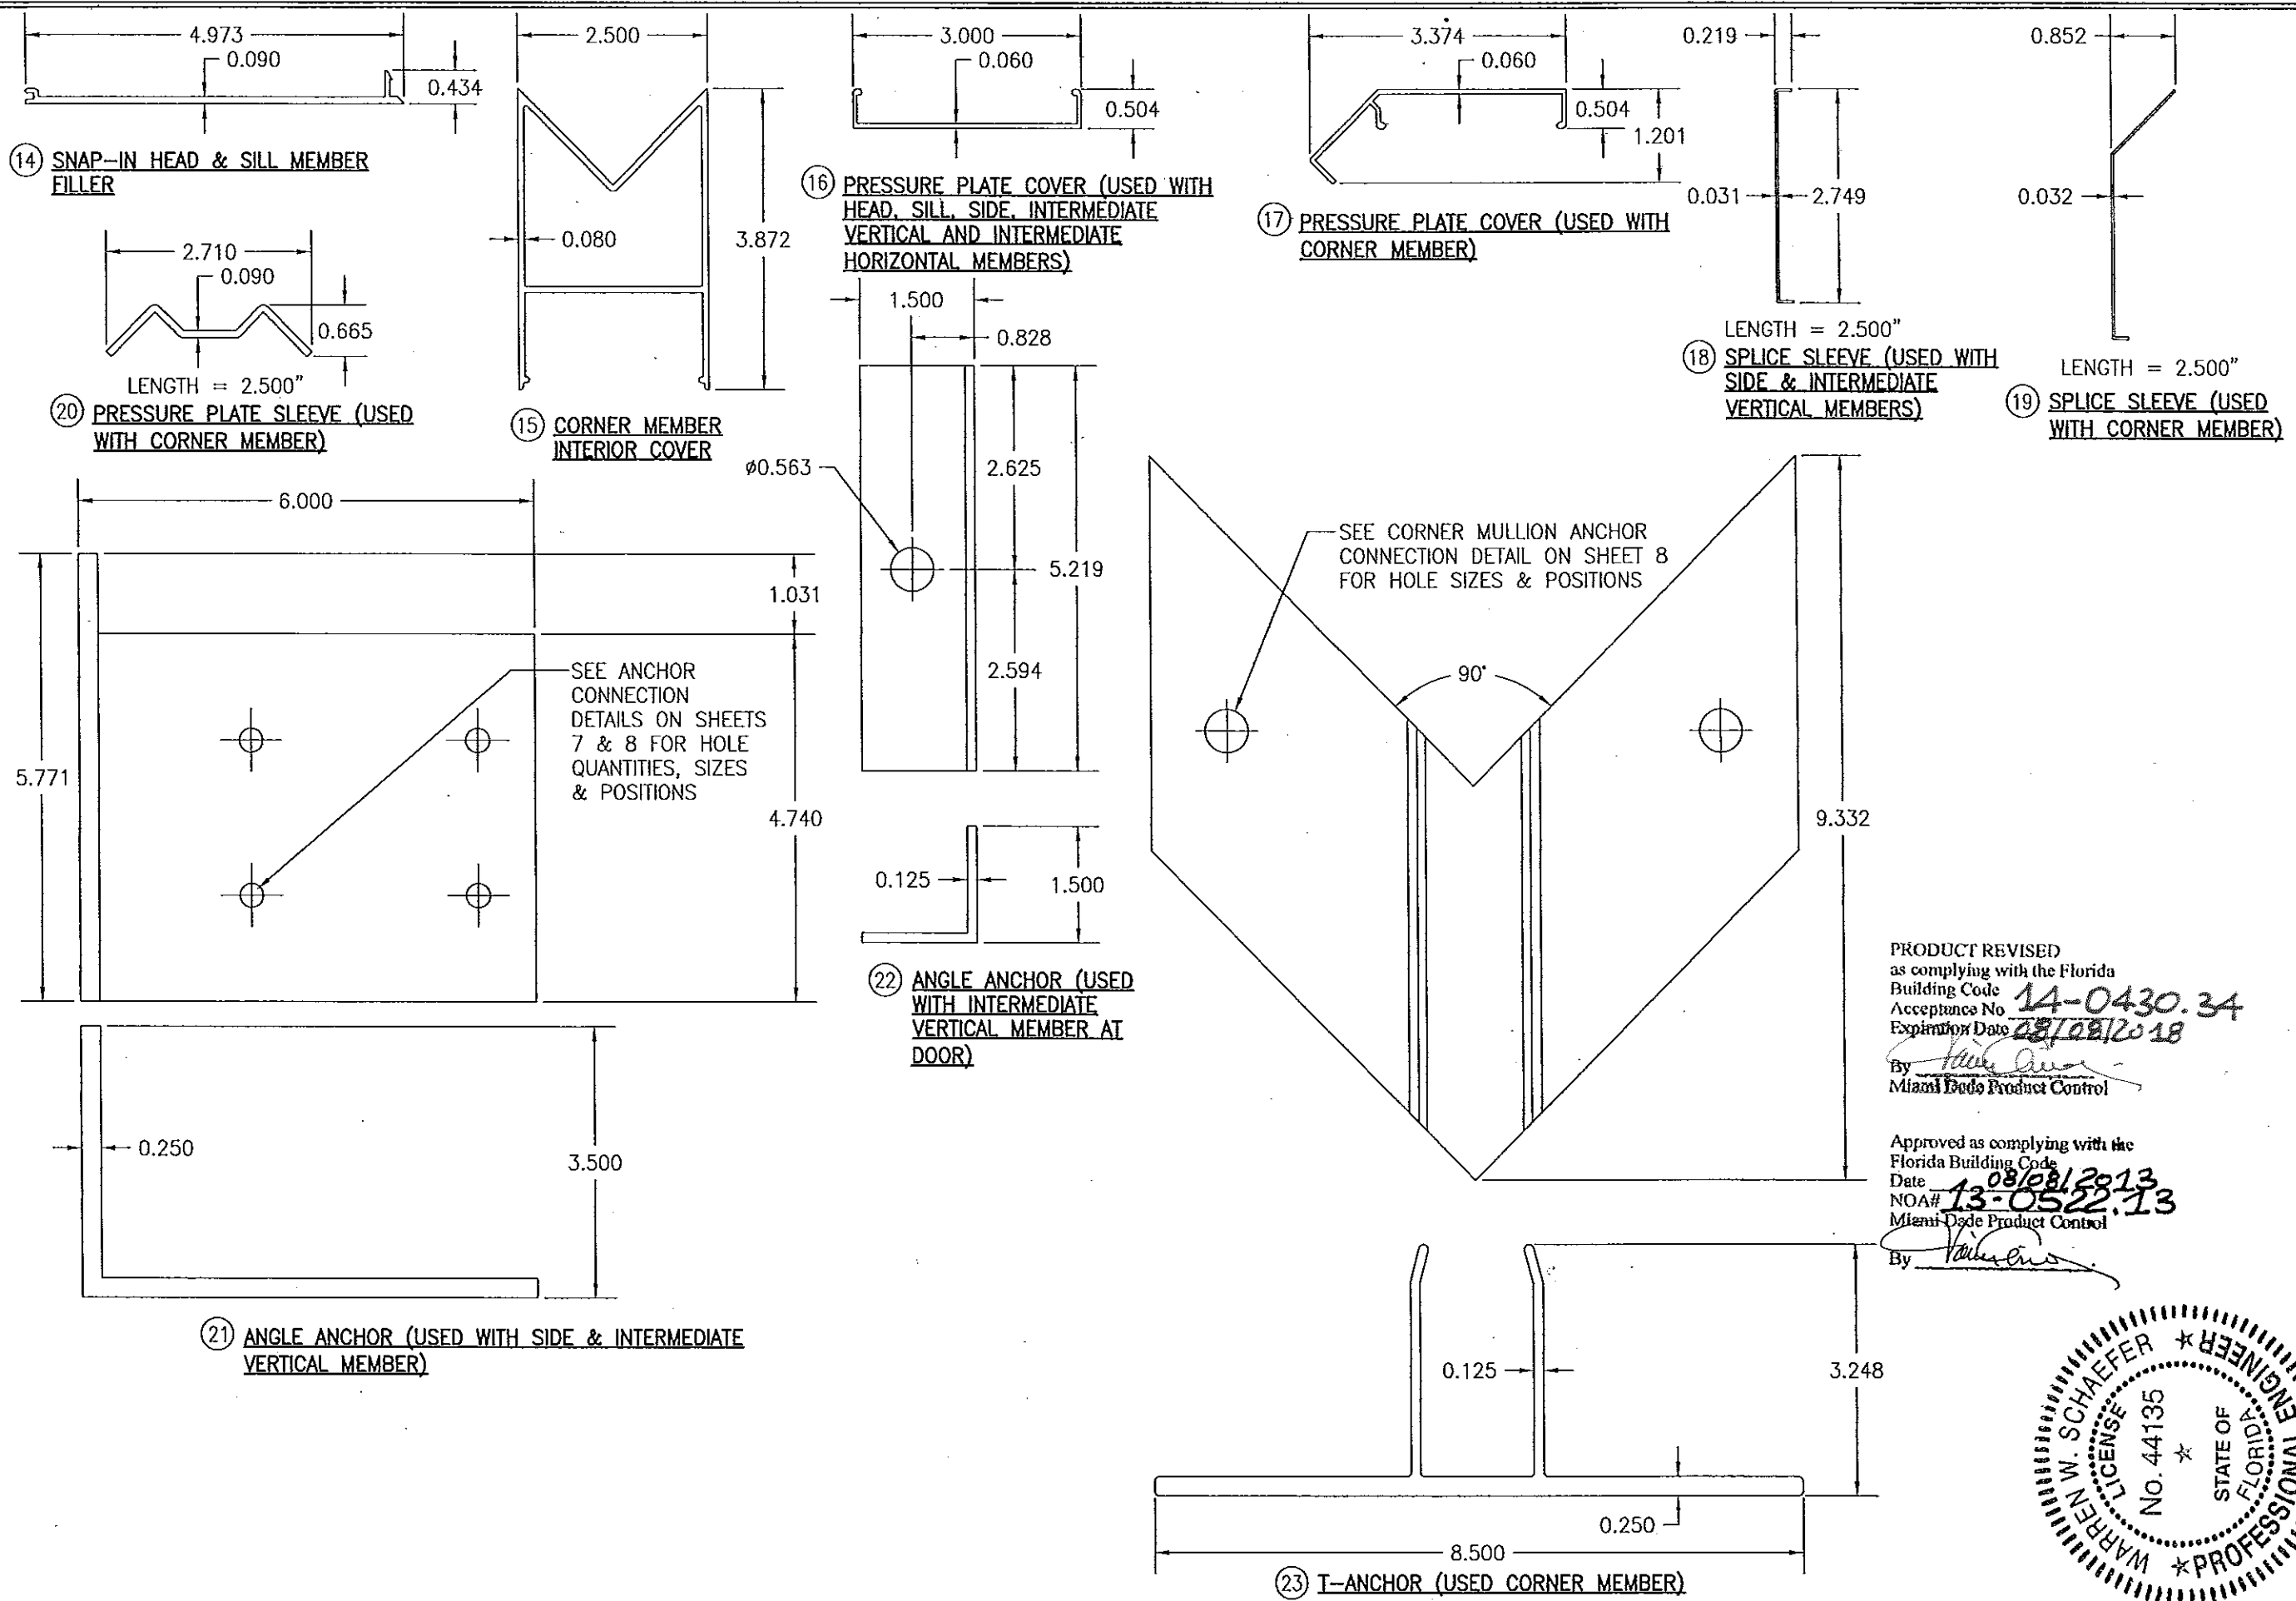


PRODUCT REVISED
as complying with the Florida
Building Code
Acceptance No. **14-0430.34**
Expiration Date **08/08/2018**
By *[Signature]*
Miami Dade Product Control


Approved as complying with the
Florida Building Code
Date **08/08/2013**
NOA# **13-0522.13**
Miami Dade Product Control
By *[Signature]*

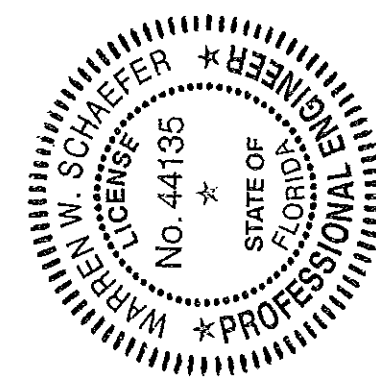


| | | | |
|--|-----|--|-------------|
| DRAWN BY: W.R.M. | | CHECKED BY: W.W.S. | |
| PLOT: 1=2 | | DATE: 01/15/13 | |
| DATE | BY | REVISION | DESCRIPTION |
| NO. | NO. | NO. | NO. |
| DRAWING TITLE: 8 13/16" DEEP 1630-SS-IR DRY GLAZED SMI CURTAIN WALL | | | |
| MANUFACTURER KAWNEER COMPANY, INC. 555 GUTHRIDGE COURT NORCROSS, GA 30092 770-449-5555 | | CONSULTANTS W. W. SCHAEFER ENGINEERING & CONSULTING, P.A. (CA 6809) 7480 150TH COURT NORTH PALM BEACH GARDENS, FL 33418 PHONE: 561-744-3424 | |
| CERTIFICATION APR 02 2013 | | DRAWING NO. 1848 | |
| WARREN W. SCHAEFER, P.E. P.E. NO. 44135 | | SHEET NO. 19 OF 21 | |

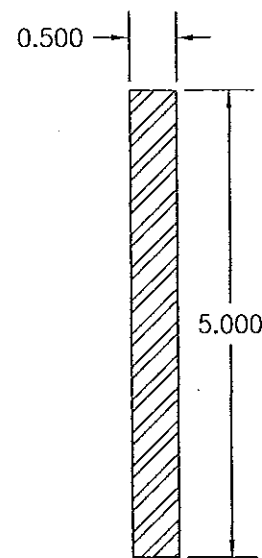


28) VERTICAL SIDE & INTERMEDIATE MEMBER REINFORCEMENT
 $I = 5.208 \text{ IN}^4$
 $S = 2.083 \text{ IN}^3$

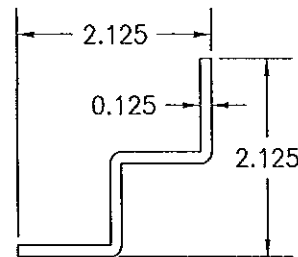


37A) SPLICE (USED WITH FLASHED 90° CORNERS)

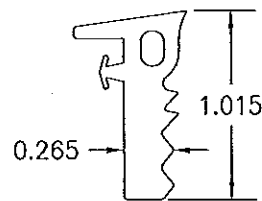


52) EXTERIOR GLAZING GASKET (USED WITH STANDARD MEMBERS)

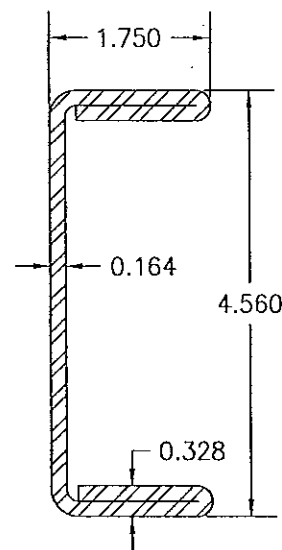


29) CORNER MEMBER REINFORCEMENT
 $I = 5.543 \text{ IN}^4$
 $S = 2.431 \text{ IN}^3$

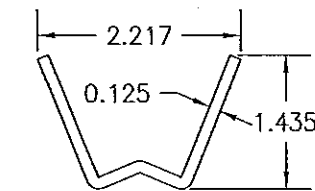


37B) SPLICE (USED WITH FLASHED 135° CORNERS)

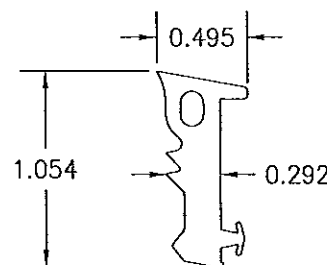


53) INTERIOR GLAZING GASKET (USED WITH STANDARD MEMBERS)

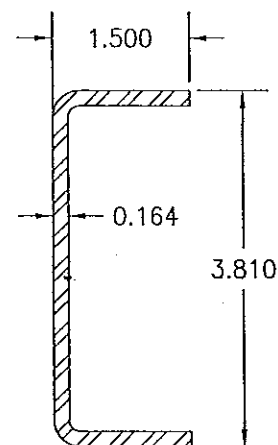


30) CORNER MEMBER REINFORCEMENT
 $I = 2.111 \text{ IN}^4$
 $S = 1.108 \text{ IN}^3$

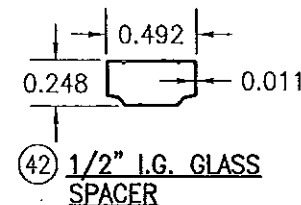


42) 1/2" I.G. GLASS SPACER

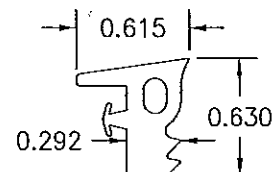


54) EXTERIOR & INTERIOR GLAZING GASKET (USED WITH CORNER MEMBERS)

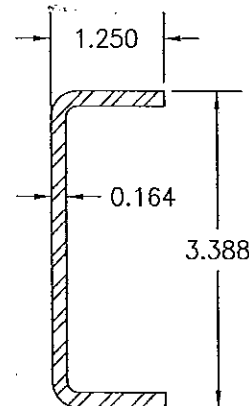


31) CORNER MEMBER REINFORCEMENT
 $I = 1.378 \text{ IN}^4$
 $S = 0.813 \text{ IN}^3$

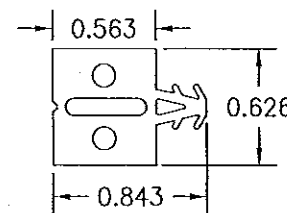

56) THERMAL SEPARATOR

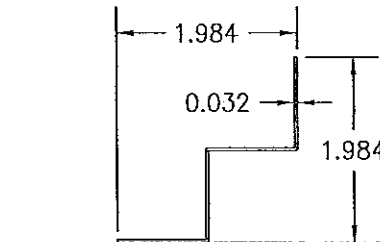


36A) SPLICE COVER (USED WITH FLASHED 90° CORNERS)

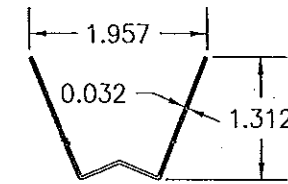

36B) SPLICE COVER (USED WITH FLASHED 135° CORNERS)

PRODUCT REVISED
 as complying with the Florida
 Building Code
 Acceptance No. 14-0430.34
 Expiration Date 08/08/2018
 By Warren W. Schaefer
 Miami Dade Product Control

Approved as complying with the
 Florida Building Code
 Date 08/08/2013
 NOA# 13-0522.13
 Miami Dade Product Control
 By Warren W. Schaefer

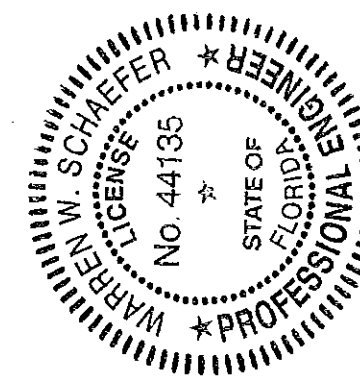

| | | | |
|---------------|--|---|--|
| DRAWING TITLE | | 8 13/16" DEEP 1630-SS-IR DRY GLAZED SMI CURTAIN WALL | |
| DRAWN BY: | | W.R.M. | |
| CHECKED BY: | | W.W.S. | |
| PLOT: | | 1=2 | |
| DATE: | | 01/15/13 | |
| NO. | | | |
| REVISION | | | |
| DESCRIPTION | | | |
| BY | | | |
| DATE | | | |
| CONSULTANTS | | W. W. SCHAEFER ENGINEERING & CONSULTING, P.A. (CA 6809) | |
| MANUFACTURER | | KAWNEER COMPANY, INC. | |
| | | 555 GUTHRIDGE COURT | |
| | | NORCROSS, GA 30092 | |
| | | 770-449-5555 | |
| CERTIFICATION | | APR 02 2013 | |
| DRAWING NO. | | 1848 | |
| SHEET NO. | | 20 OF 21 | |

| ITEM # | ITEM DESCRIPTION | MANUFACTURER/NOTES | SEALS & SEALANTS | | DRAWN BY: W.R.U. | CHECKED BY: W.W.S. |
|---|--|----------------------------------|--|---|---|-----------------------|
| PARTS | | | | | DATE: | DATE: |
| 1 | HEAD & SILL MEMBER | 6063-T6 ALUMINUM | 50 | FIXED GASKET | TREMCO TR4726P EPDM DUROMETER 65 +/-5 | 1=2 |
| 2 | INTERMEDIATE HORIZONTAL MEMBER | 6063-T6 ALUMINUM | 51 | FRAMING GASKET | INTEK 50172A SANTOPRENE DUROMETER 65 POLYPROPYLENE DUROMETER 80 | 01/15/13 |
| 3 | SIDE OR INTERMEDIATE VERTICAL MEMBER (MALE HALF) | 6063-T6 ALUMINUM | 52 | EXTERIOR GLAZING GASKET (USED WITH STANDARD MEMBERS) | TREMCO TR-20494P EPDM DUROMETER 60 +/-5 | |
| 4 | SIDE OR INTERMEDIATE VERTICAL MEMBER (FEMALE HALF) | 6063-T6 ALUMINUM | 53 | INTERIOR GLAZING GASKET (USED WITH STANDARD MEMBERS) | TREMCO TR-19828E EPDM DUROMETER 60 +/-5 | |
| 5 | CORNER MEMBER | 6063-T6 ALUMINUM | 54 | EXTERIOR & INTERIOR GLAZING GASKET (USED WITH CORNER MEMBERS) | TREMCO TR-4014P EPDM DUROMETER 60 +/-5 | |
| 6 | PRESSURE PLATE (USED WITH HEAD, SILL OR SIDE MEMBERS) | 6063-T6 ALUMINUM | 56 | THERMAL SEPARATOR | TREMCO TR-20087E EPDM DUROMETER 70 +/-5 | |
| 7 | PRESSURE PLATE (USED WITH INTERMEDIATE VERTICAL AND INTERMEDIATE HORIZONTAL MEMBERS) | 6063-T6 ALUMINUM | 57 | STEEL TO ALUMINUM SEPERATOR | THERMO-TOK TN-9004 | |
| 8 | PRESSURE PLATE (USED WITH CORNER MEMBER) | 6063-T6 ALUMINUM | FASTENERS | | | |
| 9 | SHEAR BLOCK (HEAD TO CORNER MEMBER) | 6063-T6 ALUMINUM | 60 | 1/4" X 1 1/4" HWHTFS 300 SERIES S.S. | WITHIN 3" FROM ENDS & 9" MAX. O.C. | |
| 10 | SHEAR BLOCK (SILL TO CORNER MEMBER) | 6063-T6 ALUMINUM | 61 | NO. 12 X 1" HWHTFS 300 SERIES S.S. | 2 PER FRAME END | |
| 11 | SHEAR BLOCK (INTERMEDIATE HORIZONTAL TO CORNER MEMBER) | 6063-T6 ALUMINUM | 62 | NO. 12 X 7/16" PHTF 430 SERIES S.S. | 4 PER SHEAR BLOCK | |
| 12 | SPLICE SLEEVE (USED WITH SIDE & INTERMEDIATE MEMBERS) | 6063-T6 ALUMINUM | 63 | NO. 12 X 1" PHTF 300 SERIES S.S. | 2 PER SHEAR BLOCK | |
| 13 | SPLICE SLEEVE (USED WITH CORNER MEMBER) | 6063-T6 ALUMINUM | 64 | NO. 10 X 1" FHTFS 300 SERIES S.S. | WITHIN 4 FROM ENDS & 48" MAX. O.C. | |
| 14 | SNAP-IN HEAD & SILL MEMBER FILLER | 6063-T6 ALUMINUM | 65 | 10-24 X 1" FHMS 300 SERIES S.S. | WITHIN 3" FROM ENDS & 48" MAX. O.C. | |
| 15 | CORNER MULLION INTERIOR COVER | 6063-T6 ALUMINUM | 66 | NO. 12 X 1" HWHTFS 300 SERIES S.S. | 4 PER FRAME END | |
| 16 | PRESSURE PLATE COVER (USED WITH HEAD, SILL, SIDE, INTERMEDIATE VERTICAL AND INTERMEDIATE HORIZONTAL MEMBERS) | 6063-T6 ALUMINUM | 67 | NO. 12 X 7/8" FHTFS 300 SERIES S.S. | 4 PER SHEAR BLOCK | |
| 17 | PRESSURE PLATE COVER (USED WITH CORNER MAMBER) | 6063-T6 ALUMINUM | 68 | NO. 12 X 1" PHTFS 300 SERIES S.S. | 2 PER JAMB SPLICE JOINT 1 UNDER SLICE; 4 PER INTERMEDIATE SPLICE JOINT 1 UNDER SLICE 1 UNDER CORNER SLICE JOINT | |
| 18 | SPLICE SLEEVE (USED WITH SIDE & INTERMEDIATE VERTICAL MEMBERS) | 6063-T6 ALUMINUM | 69 | NO. 12 X 3 1/2" FHTFS 300 SERIES S.S. | 4 PER JAMB SPLICE JOINT | |
| 19 | SPLICE SLEEVE (USED WITH CORNER MEMBER) | 6063-T6 ALUMINUM | 70 | 10-16 X 1 1/4" FHSDS 300 SERIES S.S. | 4 PER CORNER SPLICE JOINT | |
| 20 | PRESSURE PLATE SLEEVE (USED WITH CORNER MEMBER) | 6063-T6 ALUMINUM | 71 | 1/4-20 X 2 1/2" FHTCMS CARBON STEEL | WITHIN 4" FROM ENDS & 24" MAX. O.C. | |
| 21 | ANGLE ANCHOR (USED WITH SIDE & INTERMEDIATE VERTICAL MEMBERS) | 6063-T6 ALUMINUM | 72 | 10-16 X 3/4" PHSDS 400 SERIES S.S. | 1 PER PRESSURE PLATE SLEEVE | |
| 22 | ANGLE ANCHOR (USED WITH INTERMEDIATE VERTICAL MEMBER AT DOOR) | 6063-T6 ALUMINUM | 73 | 10 X 5/8" FHTFS 300 SERIES S.S. | 6 PER ITEM 24 | |
| 23 | ANGLE ANCHOR (USED WITH CORNER MEMBER) | 6063-T6 ALUMINUM | 74 | NO. 10 X 1/2" FHTFS 300 SERIES S.S. | 3 PER ITEM 22 | |
| 24 | 3" X 5" X 3/16" FLAT BAR | 6063-T6 ALUMINUM | <div>PRODUCT REVISED as complying with the Florida Building Code Acceptance No. 14-0430.34 Expiration Date 08/08/2018 By <i>[Signature]</i> Miami Dade Product Control</div> <div>Approved as complying with the Florida Building Code Date 08/08/2013 NOA# 13-0522.13 Miami Dade Product Control By <i>[Signature]</i></div> <div>WARREN W. SCHAEFER LICENSE No. 44135 STATE OF FLORIDA PROFESSIONAL ENGINEER</div> | | | |
| 25 | 1" X 1" X 1/8" ANGLE | 6063-T6 ALUMINUM | | | | |
| 26 | 1" X 1" X 1/8" ANGLE (LENGTH AS REQ'D) | 6063-T6 ALUMINUM | | | | |
| 28 | VERTICAL SIDE & INTERMEDIATE MEMBER REINFORCEMENT | ASTM A36 STEEL | | | | |
| 29 | CORNER MEMBER REINFORCEMENT | ASTM A1011 GRADE 50 STEEL | | | | |
| 30 | CORNER MEMBER REINFORCEMENT | ASTM A1011 GRADE 50 STEEL | | | | |
| 31 | CORNER MEMBER REINFORCEMENT | ASTM A1011 GRADE 50 STEEL | | | | |
| 32 | 2" X 5 X 3/16" FLAT BAR | ASTM A1011 GRADE 50 STEEL | | | | |
| 33 | 6" X 3" X 1/2" X 6" LONG ANGLE | 50 KSI STEEL | | | | |
| 34 | 9 1/2" X 4" X 5/8" X 6" LONG BENT PLATE | 50 KSI STEEL | | | | |
| 35 | INTERIOR FLASHING (LENGTH & BEND AS REQ'D) | H5005-H34 BRAKE METAL | | | | |
| 36A | SPLICE COVER (USED WITH FLASHED 90° CORN.) | H5005-H34 BRAKE METAL | | | | |
| 36B | SPLICE COVER (USED WITH FLASHED 135° CORN.) | H5005-H34 BRAKE METAL | | | | |
| 37A | SPLICE (USED WITH FLASHED 90° CORNERS) | H5005-H34 BRAKE METAL | | | | |
| 37B | SPLICE (USED WITH FLASHED 135° CORNERS) | H5005-H34 BRAKE METAL | | | | |
| 38 | COMMERCIAL GRADE HORESHOE SHIM | PLASTIC LOCATED AT EACH ITEM #65 | | | | |
| 42 | 1/2" I.G. GLASS SPACER | 3005 OR 3105 ALUMINUM | | | | |
| DRAWING TITLE: 8 13/16" DEEP 1630-SS-IR DRY GLAZED SMI CURTAIN WALL | | | CONSULTANTS: KAWNEER COMPANY, INC. 555 GUTHRIE COURT NORCROSS, GA 30092 770-449-5555 | | | |
| DRAWING NO. 1848 | | | SHEET NO. 21 OF 21 | | | |